

Name Stanley Kolodkin

Service No. 35

Address 16 Turning Mill Road

Lot #39 16 Turning Mill Road Location

Kind of Pipe

Size 6"

Size of Main 8"

Repair—Renewal—New Service Lucente #2023

Location JUN 5 1972

Date		Material	Amount	Total	Date		Amount
1969	33'	6" Transite pipe @10.00		330.00	4-11-72	Deposit	330.00
4-18-72	77'	6" Transite pipe					
	38'	4" Cast Iron pipe					


DATE _____

TOWN OF LEXINGTON — BOARD OF PUBLIC WORKS

SEWER DIVISION

Sketch of Service Here **16**

Lot 39

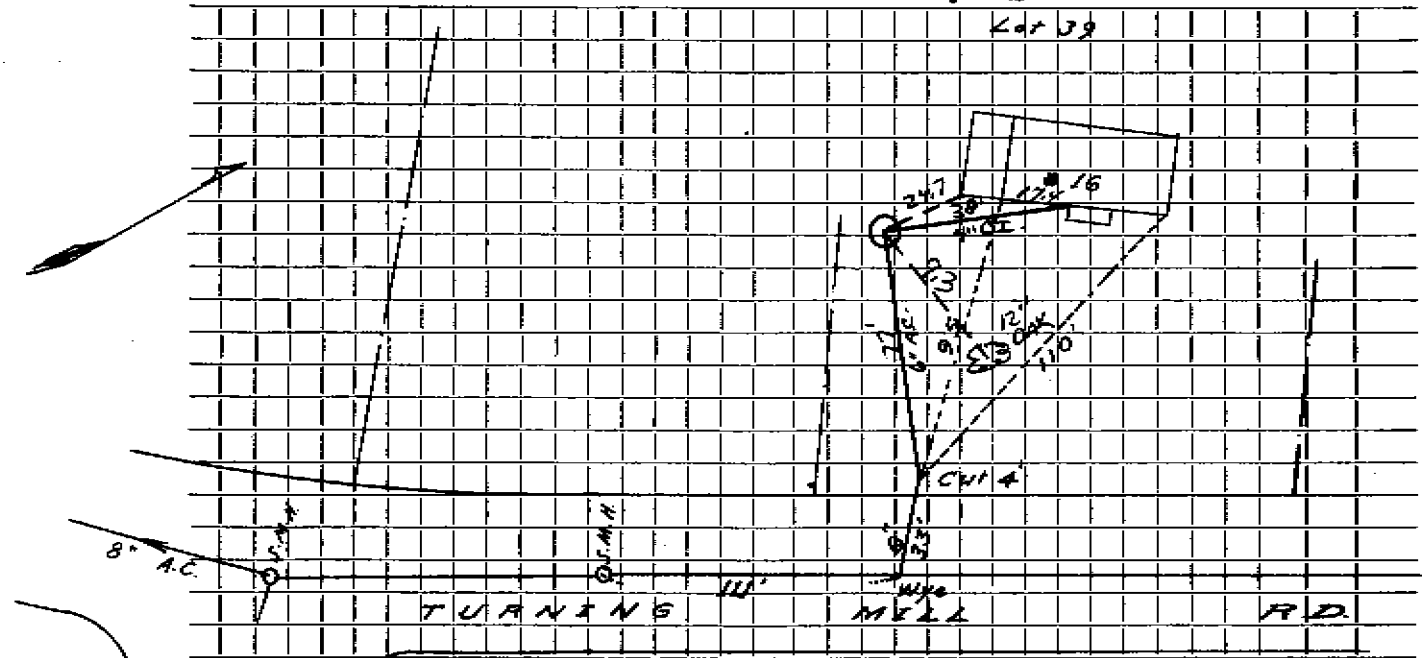

Connection made Street. Work completed

Remarks:
.....
.....

PATRICK RD.