


TOWN OF LEXINGTON — BOARD OF PUBLIC WORKS

SEWER DIVISION

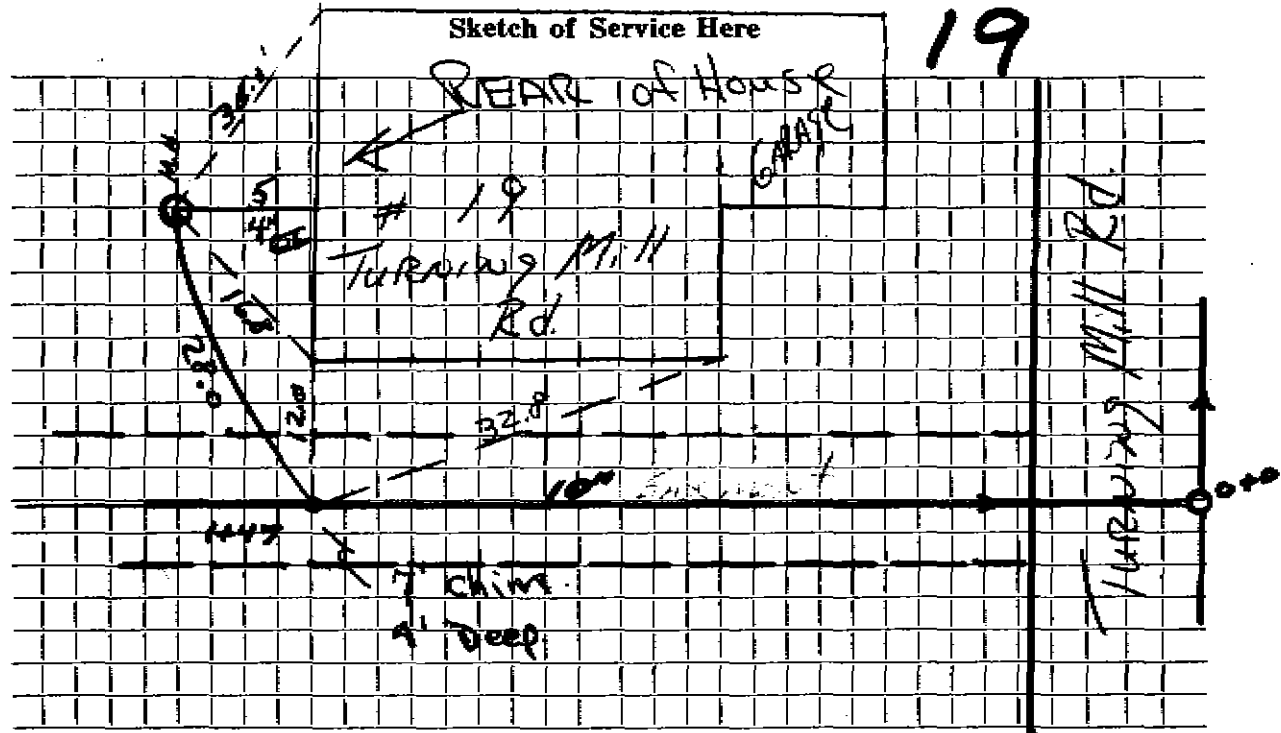

PLOTTED
P.E.V.
7/26/72

Connection made in Street. Work completed

Remarks:
.....
.....