

Name Isaac Kliger

Service No. 26

Address 20 Turning Mill Road

Lot #56 20Turning Mill Road Location

Kind of Pipe

Size 6"

Size of Main 8"

Repair—Renewal—New Service Valeri #1345

Location JUL 7 1969

Date	Material	Amount	Total	Date	Amount
1969	30' 6" Transite pipe @10.00		300.00	5-7-69	300.00
5-23-69	138' 6" Transite pipe				
?	5' 4" Cast Iron pipe				


DATE _____

TOWN OF LEXINGTON — BOARD OF PUBLIC WORKS

SEWER DIVISION

Sketch of Service Here

20

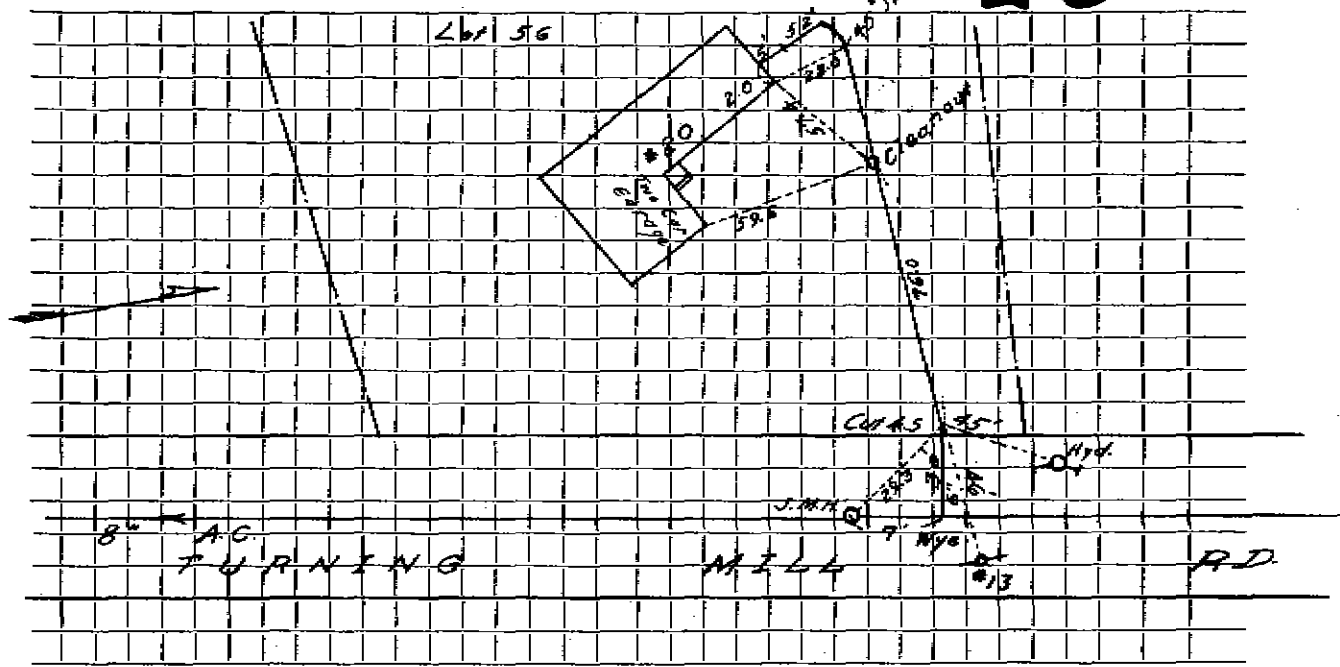

Connection made in Street. Work completed

Remarks:

.....

.....