

Service No. 36

Name SILVAN SCHVEBER

Address 22 Turning Mill Road

Lot #55 22 Turning Mill Road Location

Kind of Pipe

Size 6"

Size of Main 8"


Repair—Renewal—New Service Valari #1352

Location JUL 7 1969

Date	Material	Amount	Total	Date	Amount
1969	33' 6" Transite pipe @10.00		330.00	5-13-69	
6-4-69	90' 6" Transite pipe			Papers P	
	10' 4" Cast Iron pipe				

TOWN OF LEXINGTON — BOARD OF PUBLIC WORKS
SEWER DIVISION

Sketch of Service Here **22**

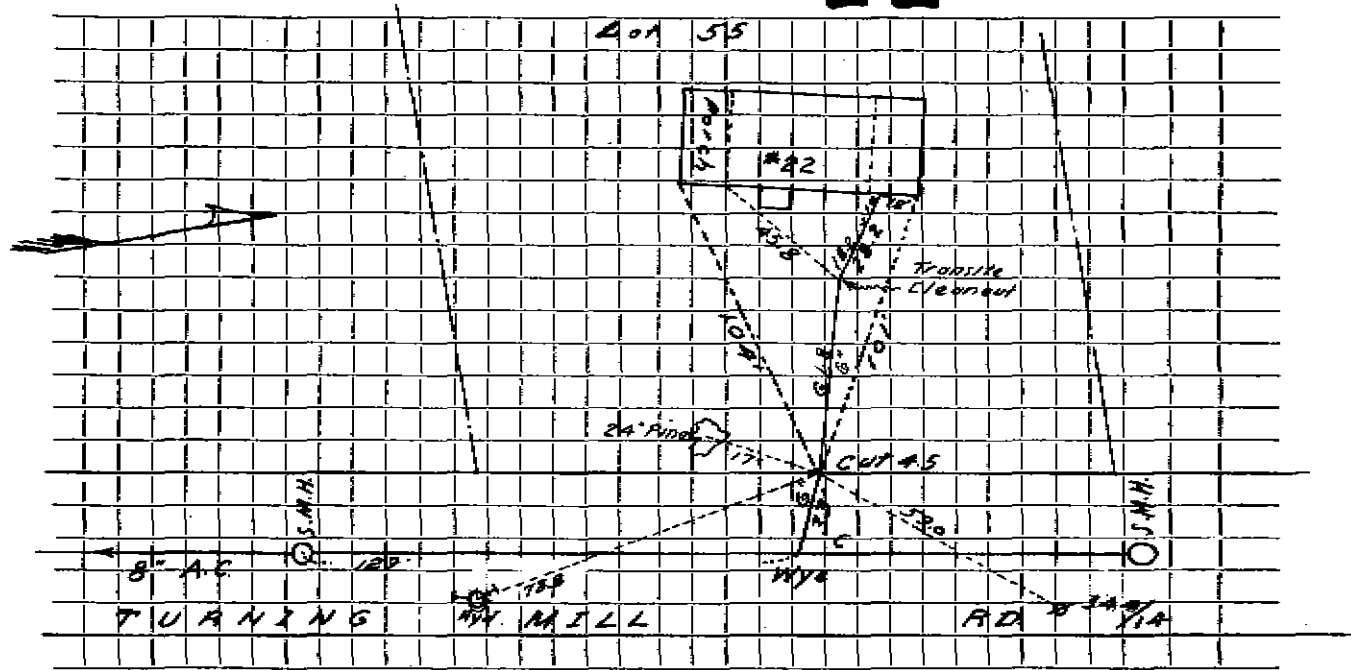

Connection made in Street. Work completed

Remarks:
.....
.....