


DATE _____

TOWN OF LEXINGTON — BOARD OF PUBLIC WORKS
SEWER DIVISION

Sketch of Service Here **24**

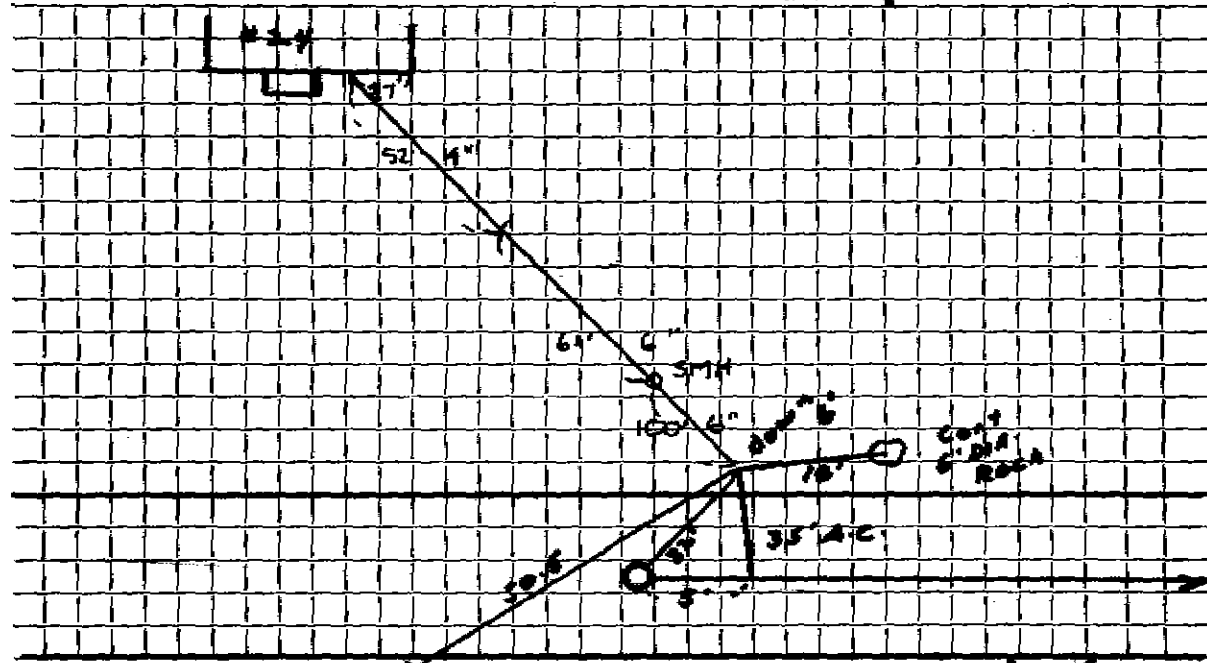

Connection made in **39 TURNING Hill** Street.

Work completed **4/9/76**

Remarks:

.....

.....