





TOWN OF LEXINGTON — BOARD OF PUBLIC WORKS

SEWER DIVISION

DATE \_\_\_\_\_

26

Sketch of Service Here

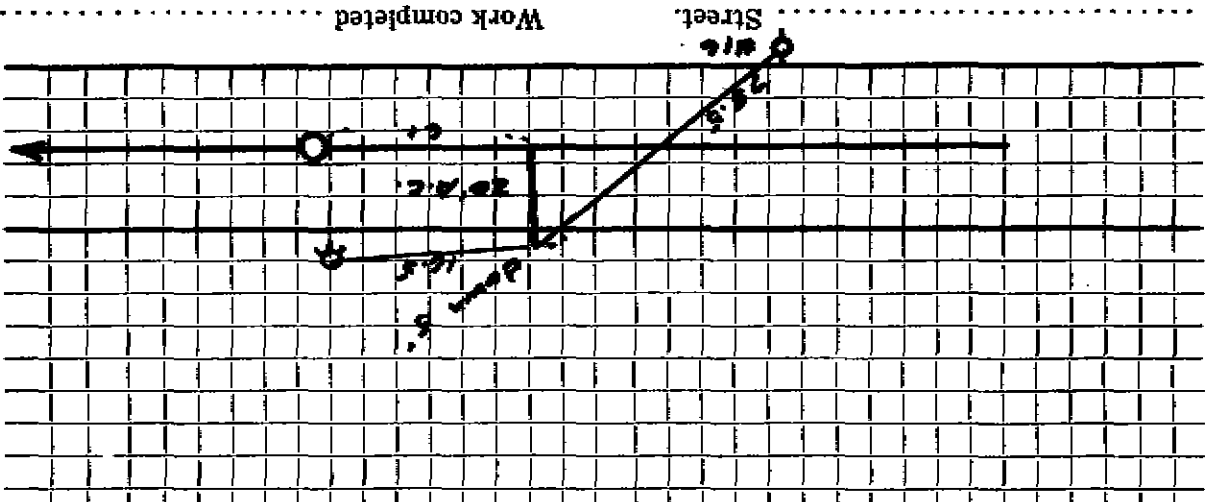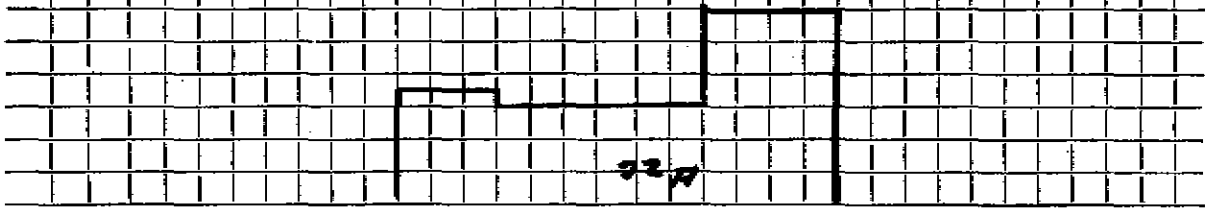

Connection made in  
Remarks: