

Name

JAMES EVANS

Service No. 16

Address # 29 TURNING MILL RD.

29 TURNING MILL R1

Location

Kind of Pipe

A.C.PVC

Size

6"

Size of Main ● "ACP

Repairs—Renewal—New Service Kirkland 4464


Location SEP 17 1984

Date		Material	Amount	Total	Date	Amount
4/26/84		23' A.C.P. 10.00	230.00		5-21-84	230.00
6/6/84	52'	6" x 6" PVC				
1		6" x 4" DONUT				
1		6" PVC x ACP Adaptor				

DATE April 25, 1975

TOWN OF LEXINGTON — BOARD OF PUBLIC WORKS
SEWER DIVISION

Sketch of Service Here **29**

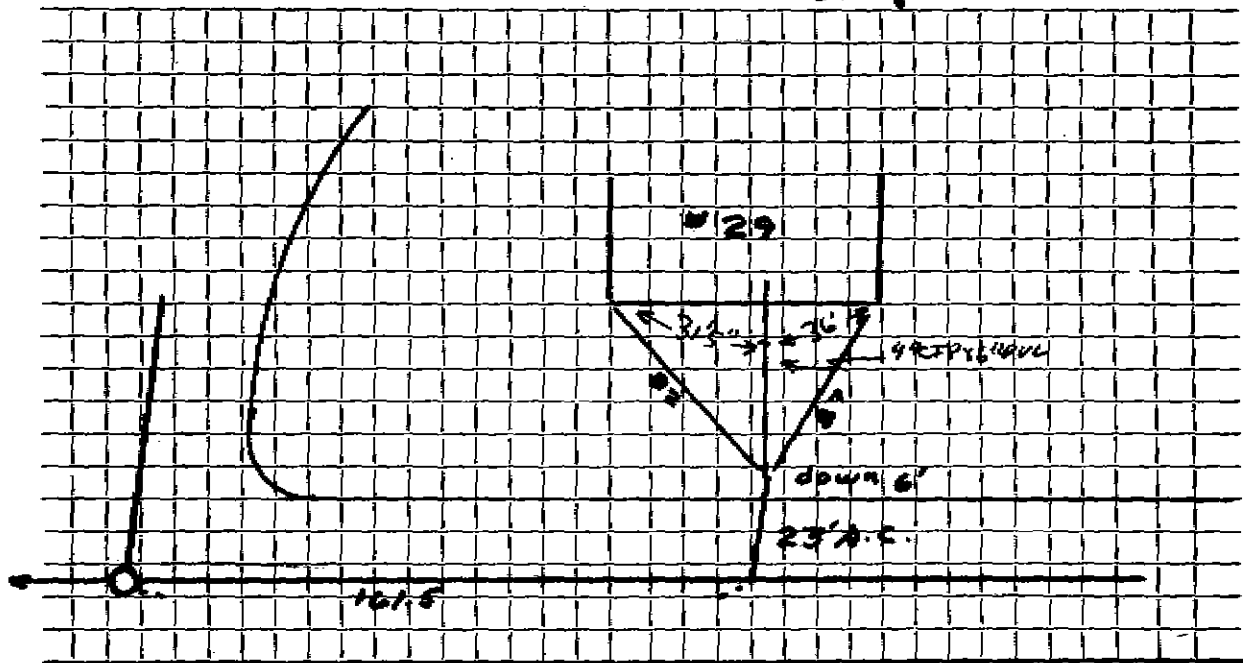

Connection made in ROBINSON RD Street. Work completed JUNE 5, 1984

Remarks:

.....

.....