

Name Daniel Murphy

Service No. 192

Address #3 Turning Mill Rd Lot 26

3 Turning Mill Road

Location

FEB 12 1973

Kind of Pipe

Size 6"

Size of Main 10"

Repair—Renewal—New Service

Bruce McKee #2245

Location

Date		Material	Amount	Total	Date	Amount	
967	271	6" Transite Pipe @ 7.00		189 00	12/19/72	Deposit	189 00
128/72	6'	6" Transite					
	10'	4" Cast Iron					


DATE _____

TOWN OF LEXINGTON — BOARD OF PUBLIC WORKS

SEWER DIVISION

Sketch of Service Here

3

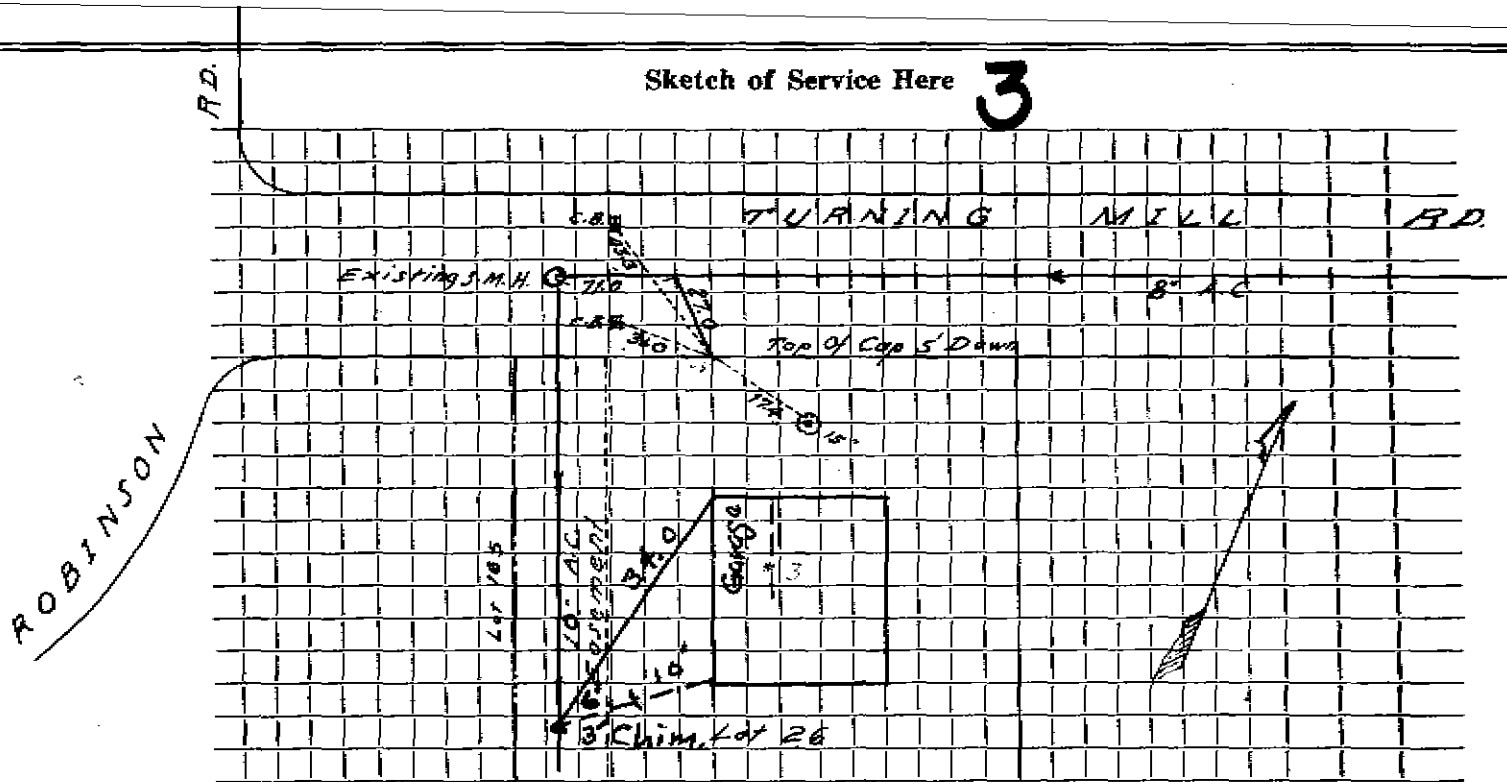

Connection made in Street.

Work completed

Remarks:

.....

.....