

Name **Julio Siegel**

Service No. 57 (75)

Address **#30 TURNING MILL Rd.**

30 TURNING Mill Road

Location

Kind of Pipe **A.C.**

Size **6"**

Size of Main **8"**

Repair—Renewal—New Service **Valeri #2714**

Location **AUG 16 1976**

Date		Material	Amount	Total	Date		Amount
4/25/75		21' A.C. @ 10.00	210 00		6-10-75	Deposit	210 00
6/11/75	106.5'	6" Transite Pipe					
	9'	4" Cast Iron Pipe					


.B.K. 18501

TOWN OF LEXINGTON — BOARD OF PUBLIC WORKS

SEWER DIVISION

DATE _____

Sketch of Service Here
30

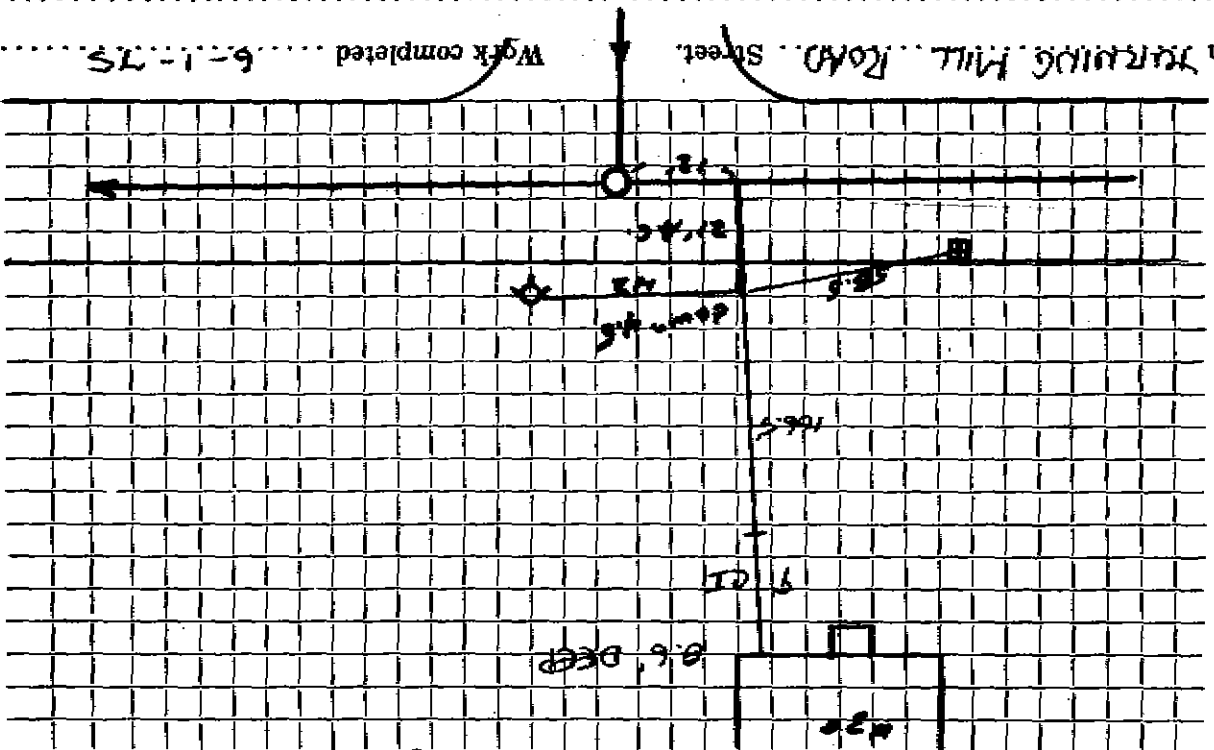

Remarks: