

Name

Service No.

Address 31 TURNING MILL RD.

Location

Kind of Pipe AC - PVC Size 6" Size of Main 8"

Repair—Renewal—New Service Sewer MAR

Location

Date	Material	Amount	Total	Date	Amount
1/24/75	17' A.C. PIPE 10-FT	170			
8/99	153' 6" PVC				
	1 22"				
	1 11 1/4"				
	1 WYE CLEAN OUT				
	1 WYE FOR APPROX				
	1 Man Hole C.O.				
	1 6" FENCE				
	1 6x4 FENCE				
3/18/02	Service for addition post into existing service				
	11' - 6" PVC				
	6' - 4" PVC				
	4x4x4 PVC	clean out			


DATE _____

TOWN OF LEXINGTON — BOARD OF PUBLIC WORKS

SEWER DIVISION

Sketch of Service Here

31

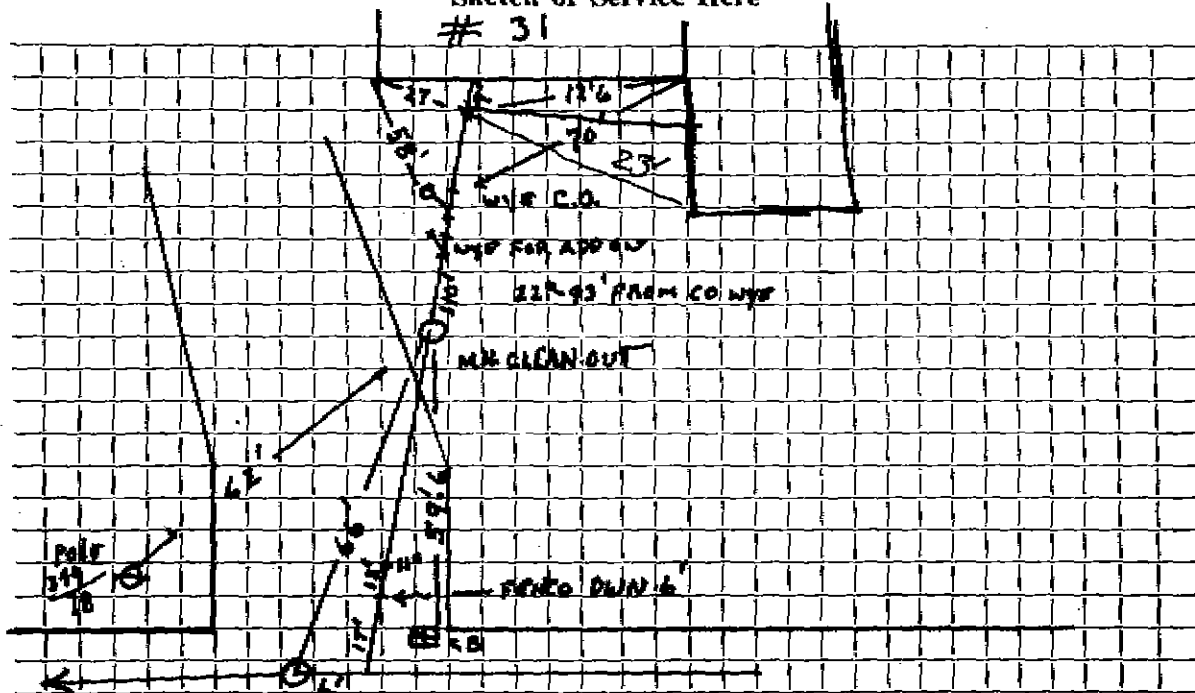

Connection made in Street. Work completed

Remarks: *INSPE. BY BR. DT. J.M. TA. ?* Addition put on and line tied
IN TO EXISTING SERVICE