


DATE _____

TOWN OF LEXINGTON — BOARD OF PUBLIC WORKS

SEWER DIVISION

Sketch of Service Here
32

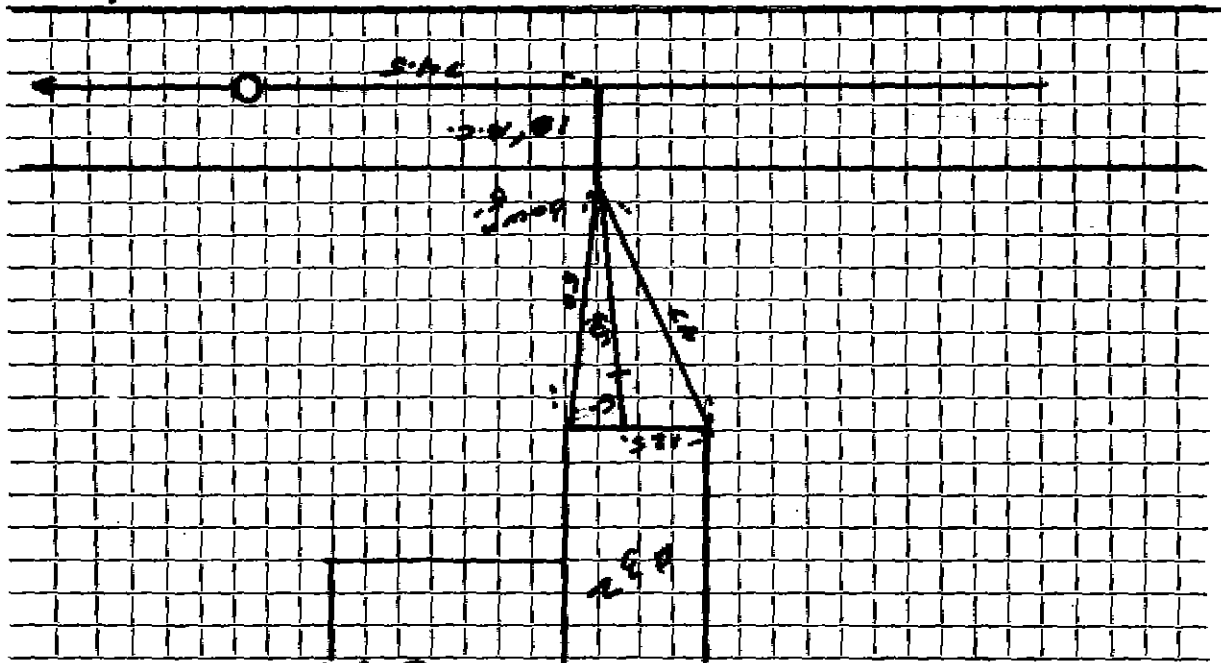

20

Connection made in #32 Turning Mill Street.

Work completed

7/31/25

Remarks: