


DATE _____

TOWN OF LEXINGTON — BOARD OF PUBLIC WORKS

SEWER DIVISION

Sketch of Service Here **33**

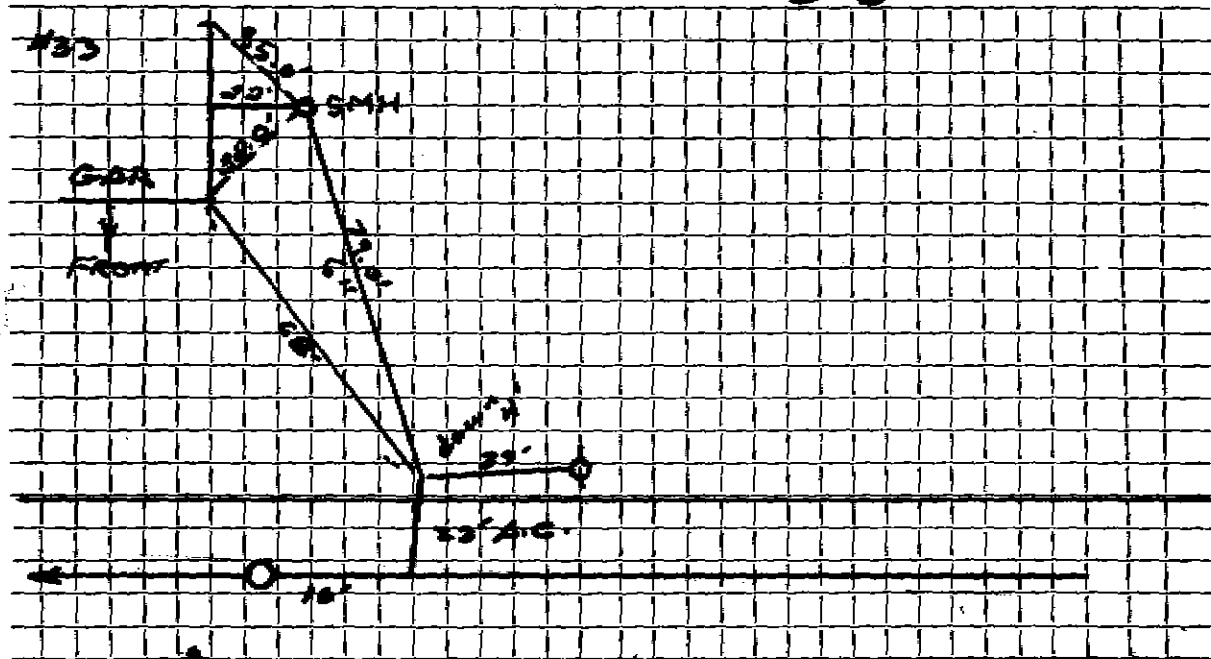

Connection made in *33* *Turning Mill* Street. Work completed *6/11/15*

Remarks:

.....

.....