


DATE _____

TOWN OF LEXINGTON — BOARD OF PUBLIC WORKS
SEWER DIVISION

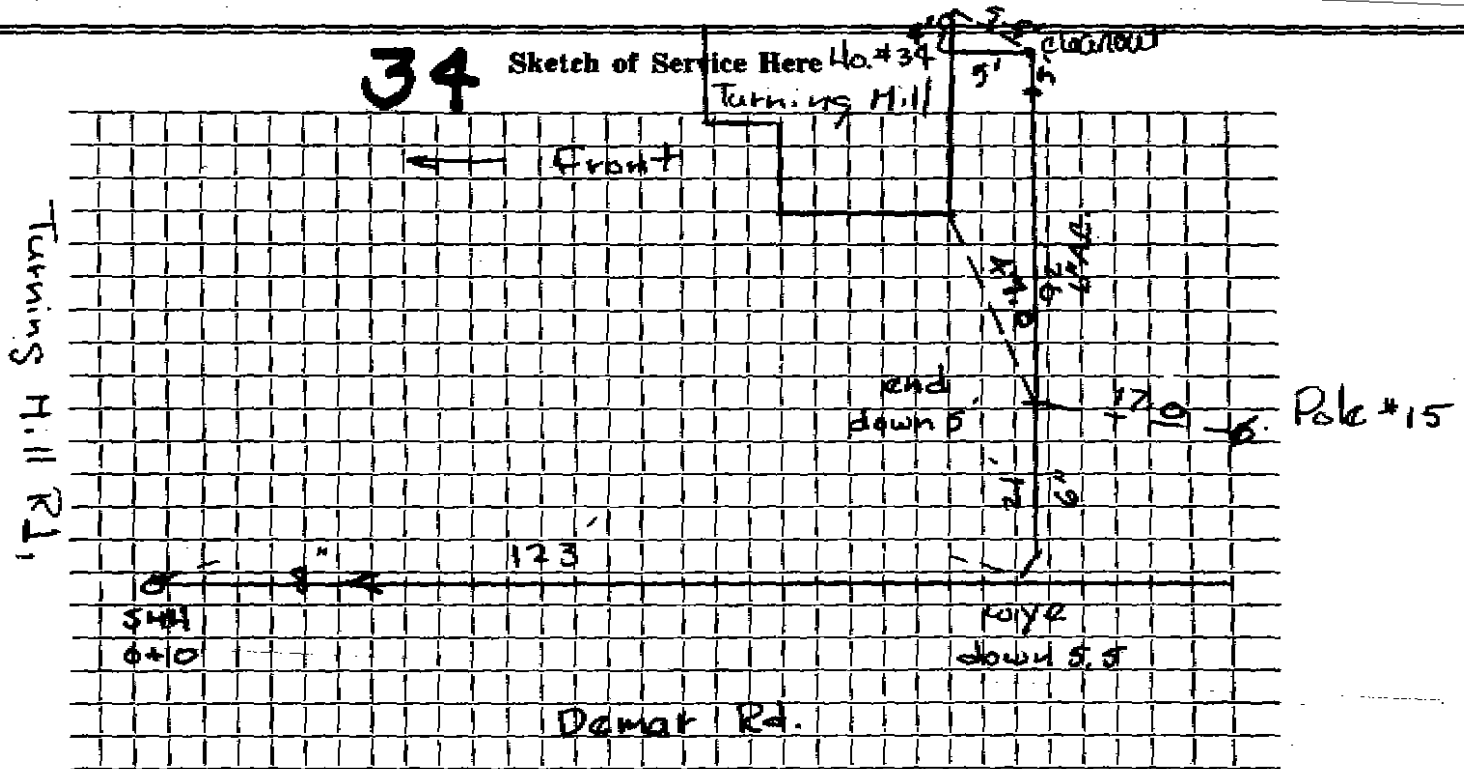

Connection made in Damar Rd. Street. Work completed April 9, 1976

Remarks: _____

