

Name

Service No.

Address 35 TURNING MILL RD.

Location

Kind of Pipe PVC

Size 6"

Size of Main

Repair—Removal—New Service Duct 300 ft


Location

Date	Material	Amount	Total	Date	Amount
8/2006	CAST Iron				
1	6x6x6 Cleareout				
95'	6" R/C				
1	22° Sweep				
1	6" A.C. PVC Tee				
	EXIST AC. Pipe				
	INFO. old Card				

TOWN OF LEXINGTON — BOARD OF PUBLIC WORKS
 DATE _____

SEWER DIVISION

Sketch of Service Here

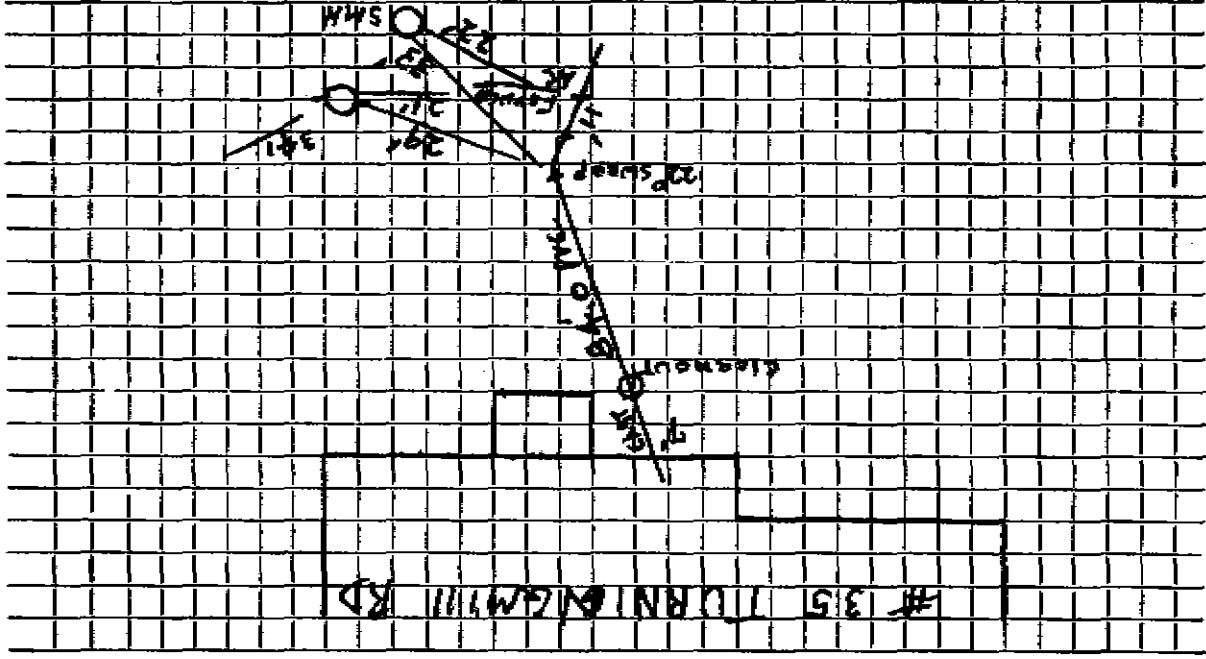

Connection made in Street. Work completed 8/2006. Drawn by J. (S.M.)


Remarks:

DATE _____

TOWN OF LEXINGTON — BOARD OF PUBLIC WORKS
SEWER DIVISION

Sketch of Service Here

35

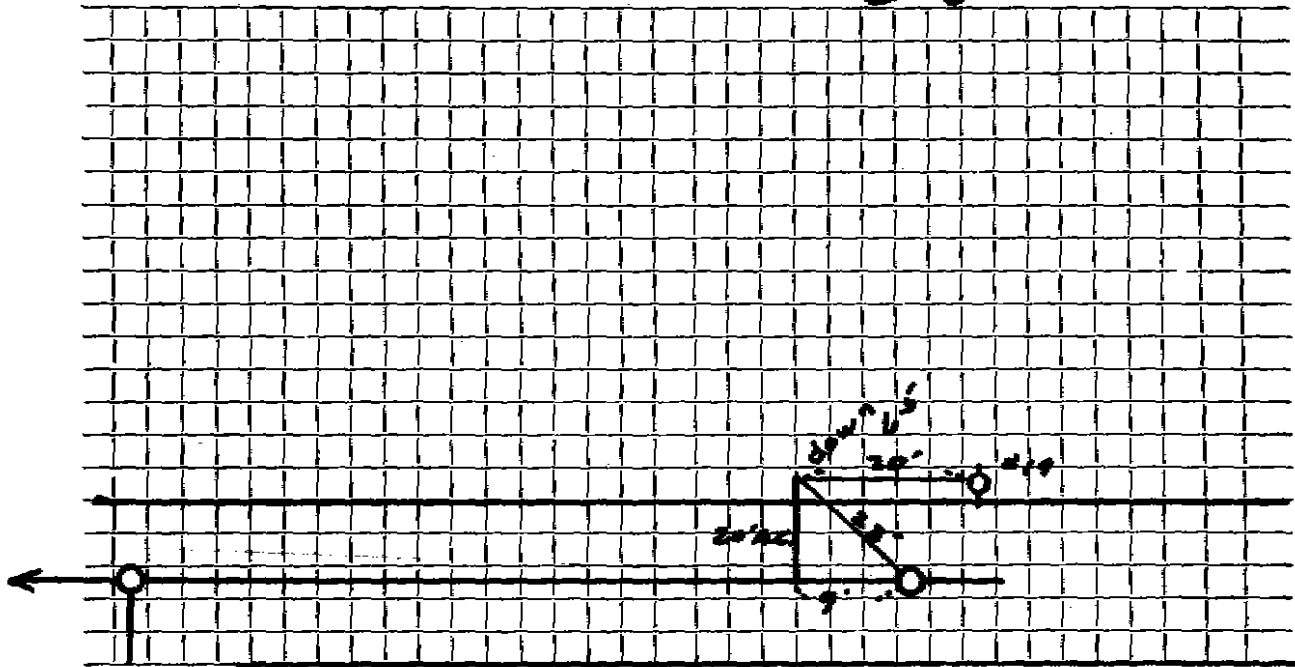

Connection made in Street. Work completed

Remarks:

.....

.....