


DATE _____

TOWN OF LEXINGTON — BOARD OF PUBLIC WORKS

SEWER DIVISION

Sketch of Service Here **37**

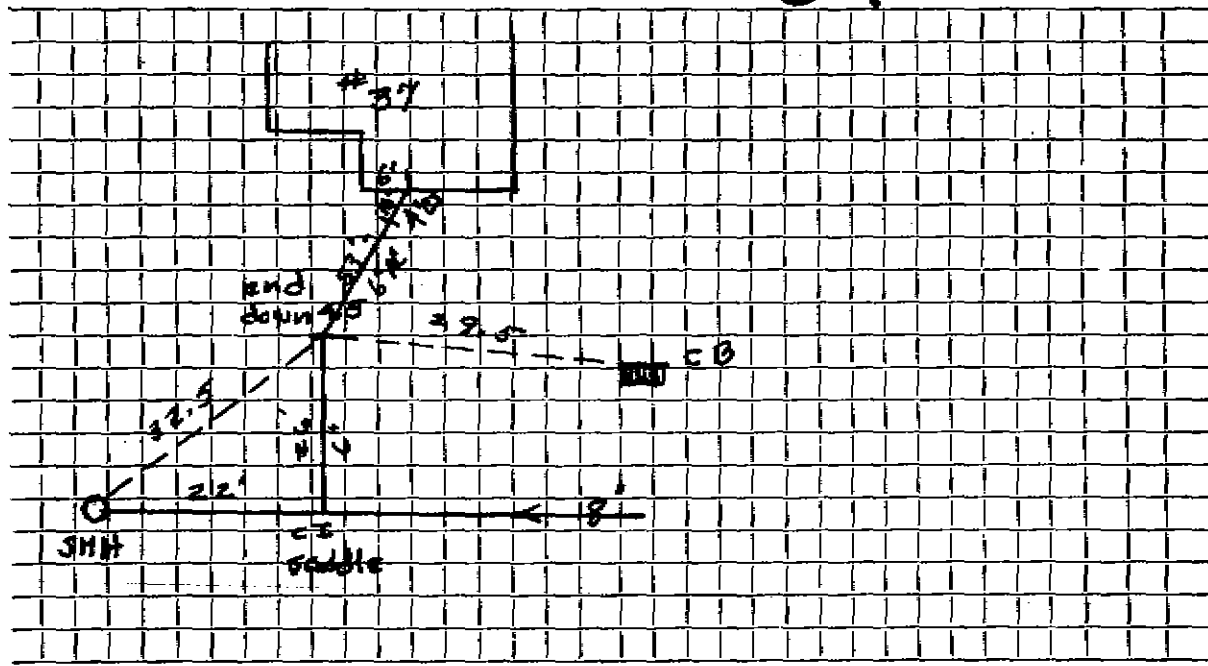

Connection made in Turning Hill Rd. Street. Work completed ... 4-8-76

Remarks:

.....

.....