




DATE July 1984

TOWN OF LEXINGTON — BOARD OF PUBLIC WORKS

SEWER DIVISION

Sketch of Service Here **38**

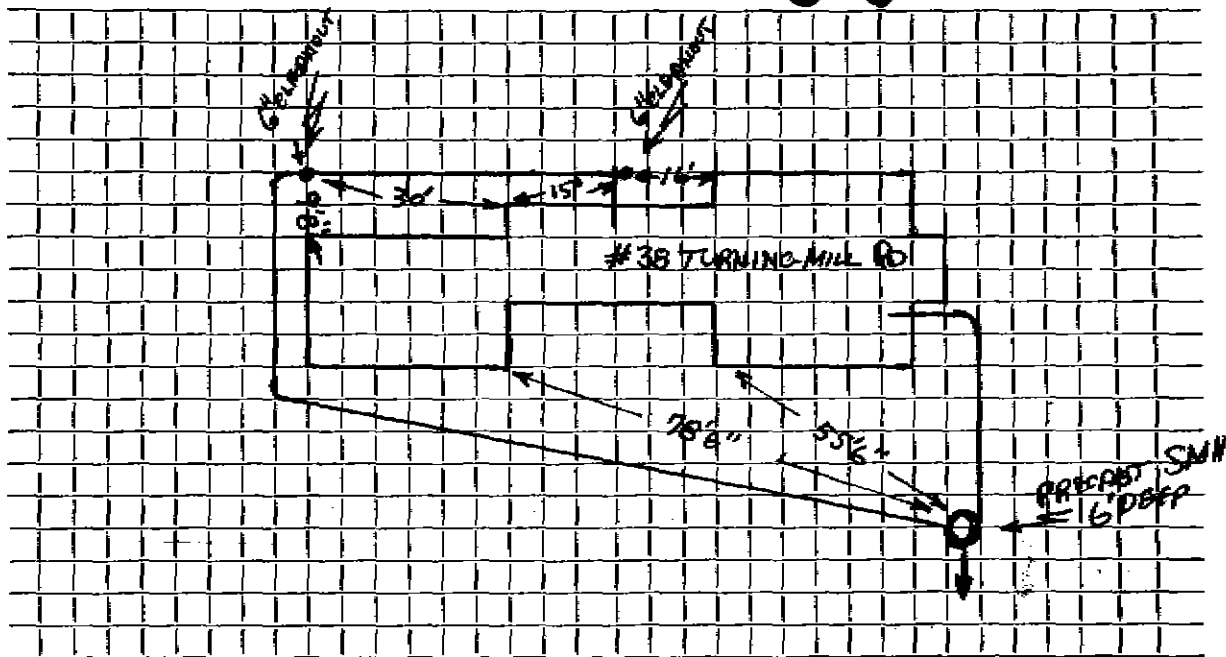

Connection made in TURNING MILL RD Street. Work completed July 1984

Remarks: .....

.....

.....