

Name DJ MORRIS

Service No. WW-21-42

Address 39 TURNING MILL ROAD

Location

Kind of Pipe SDR-35

Size 6"


Size of Main

Repair—Renewal—New Service

Location

Date	Material	Amount	Total	Date	Material	Amount
6/20/21	SDR-35 6"	5'			MATERIAL	30'
	45° BEND 1 (L.O.T)	①			220 BEND	①
	SDR-35 6"	35'			SDR-35	29'
	220 BEND	①			Cleanout 6"	①
	SDR-35	29'			SDR-35	8'
	220 BEND	①			6X6 FEMCO 16	①
	SDR-35	31'			A.C. PIPE	
	220 BEND 1 (L.O.T)	①				


Connection m:
Remarks: . . .

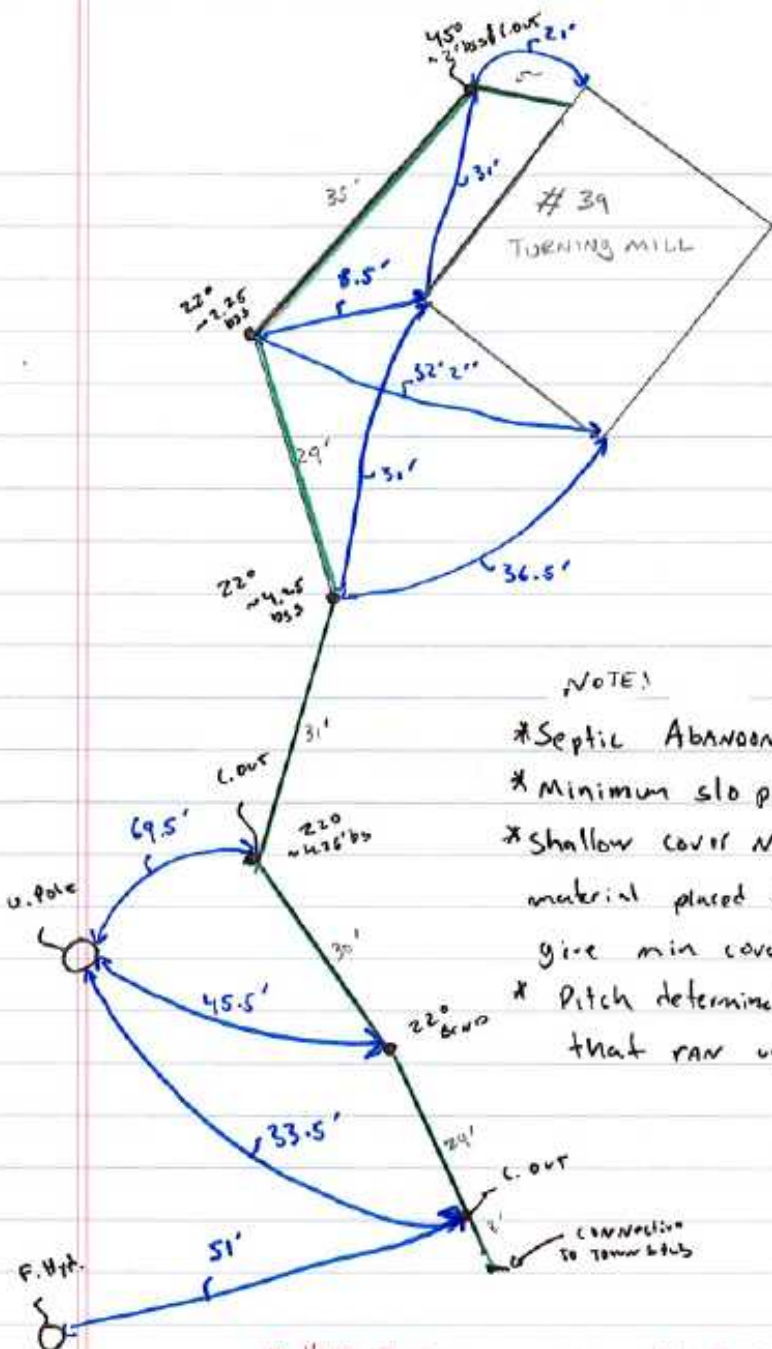

NOTE:

- * Septic Abandonment
- * Minimum slope at 2% used
- * Shallow cover near house, additional material placed on top of s.p.c.s to give min cover at 1.5-2.0 ft
- * Pitch determined from town stub that ran up to property line.

* HAD INSTALLED INTRUDER HOLE DOWN HOUSE CLEANOUT TO CONFIRM FLOW TO CONFIRM PITCH. ∴ PASSED ✓

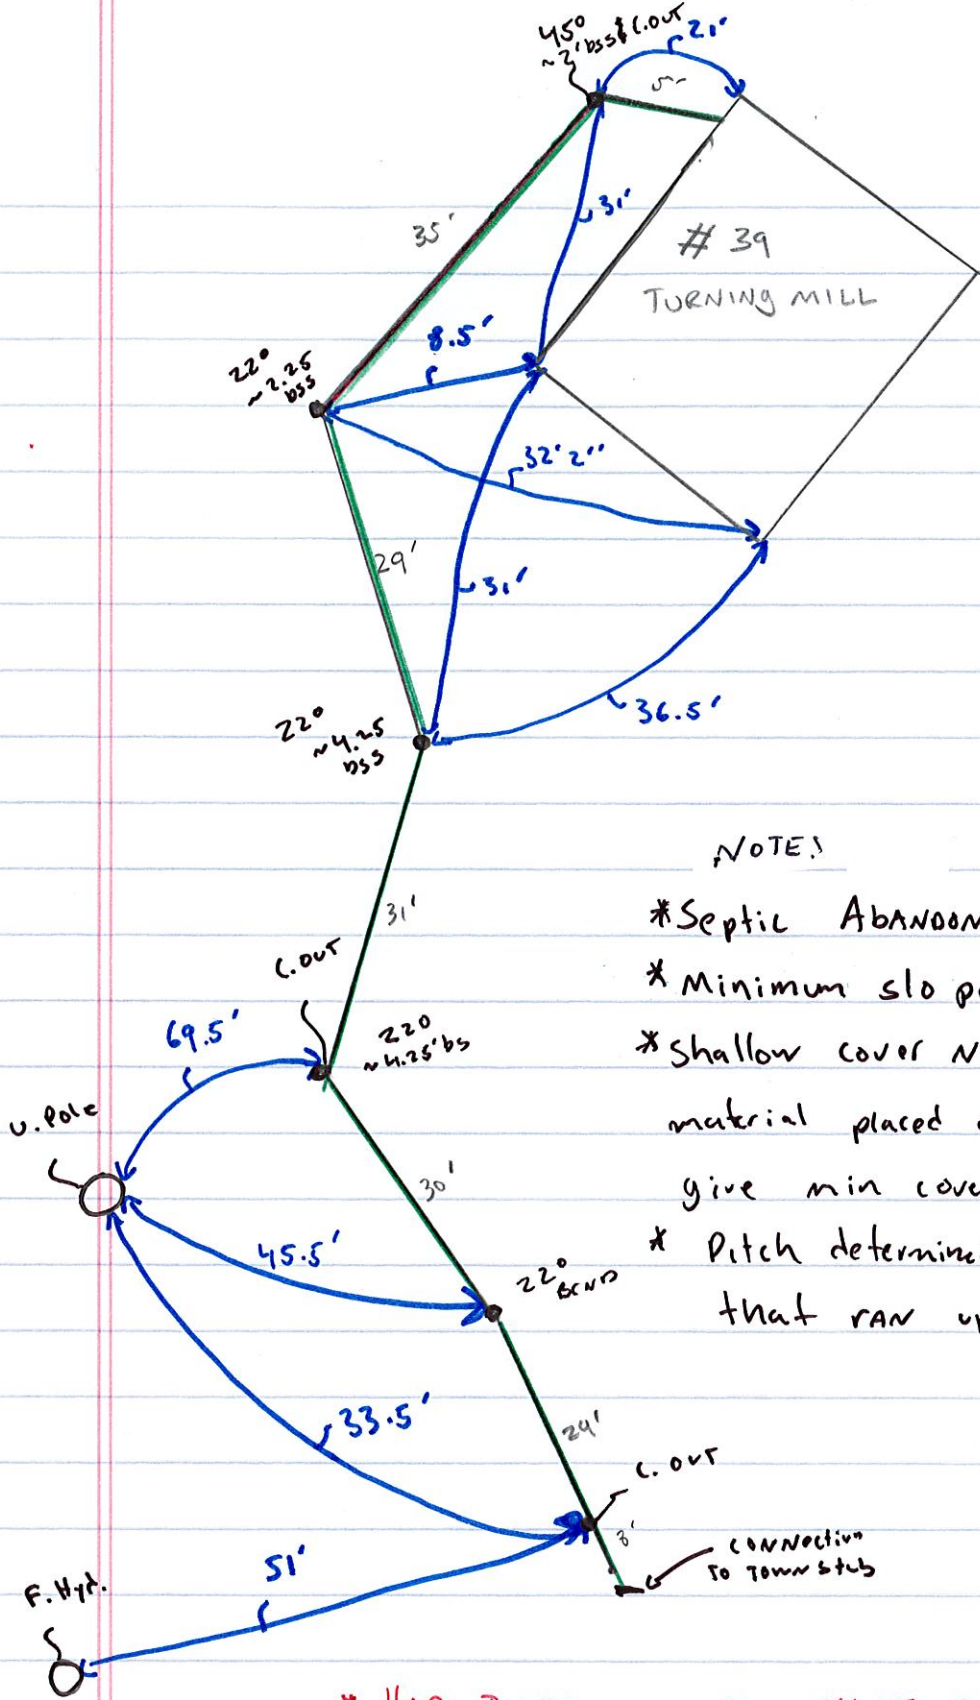

NOTE:

- * Septic ABANDONMENT
- * Minimum slope of 2% used
- * Shallow cover near house, addition material placed on top of SPR-35 to give min cover of 1.5-2.0 ft
- * Pitch determined from town stub that ran up to property line.

* HAD INSTALLER THROW HOSE DOWN HOUSE CLEANOUT TO CONFIRM FLOW TO CONFIRM PITCH. ∴ PASSED ✓

Name

Service No.

Address #39 TURNING MILL RD.

39 TURNING MILL ROAD

Location

Kind of Pipe

A.C.

Size

6"

Size of Main

8"

Repair—Renewal—New Service

Location

Date	Material	Amount	Total	Date	Amount
4/24/75	20' A.C. @ 10.00		200.00		


DATE _____

TOWN OF LEXINGTON — BOARD OF PUBLIC WORKS

SEWER DIVISION

Sketch of Service Here

39

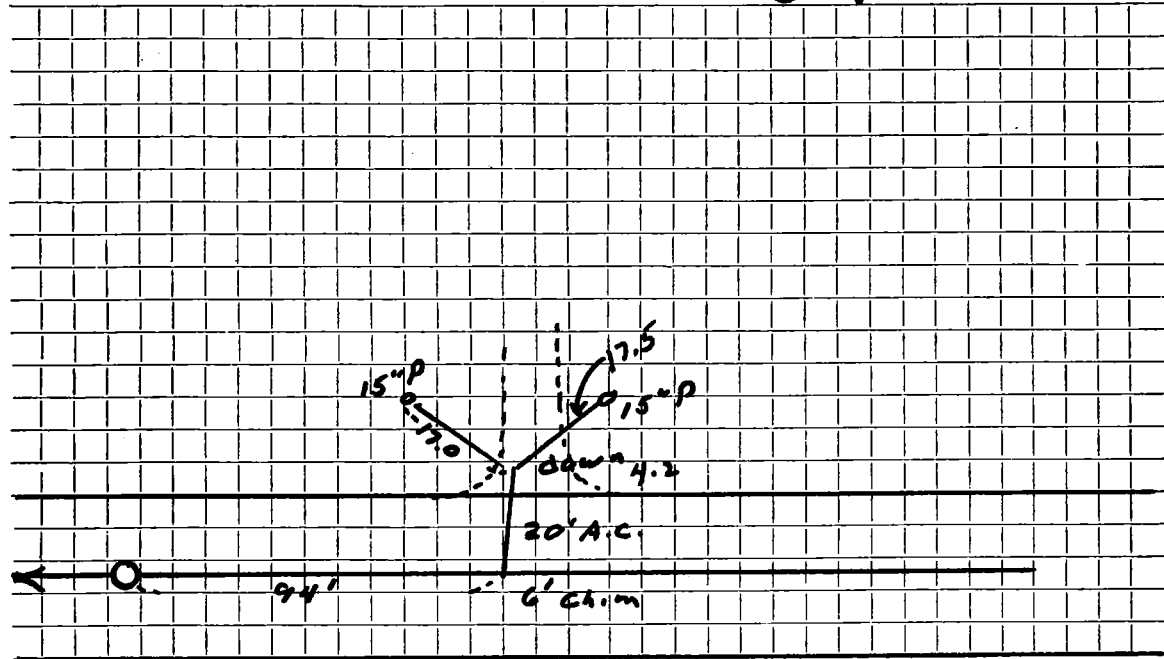

Connection made in Street. Work completed

Remarks:
.....
.....