

Name **Mr. Daniel M. Holland**

Service No. **75 (75)**

Address **41 TURNING MILL RD**

**41 Turning Mill Road**

Location

Kind of Pipe **A.C.**

Size **6"**

Size of Main **8"**

Repair—Renewal—New Service **Valeri #2730**


Location **AUG 16 1976**

Date	Material	Amount	Total	Date	Amount	
<i>4/24/75</i>	<i>21' A.C. @ 10.00</i>		<i>210 00</i>	<i>8-1-75</i>	<i>Deposit</i>	<i>210 00</i>
<i>8/14/75</i>	<i>100' 6" Transite Pipe</i>					
	<i>6' 4" Cast Iron Pipe</i>					

DATE \_\_\_\_\_

TOWN OF LEXINGTON — BOARD OF PUBLIC WORKS  
SEWER DIVISION

Sketch of Service Here **41**

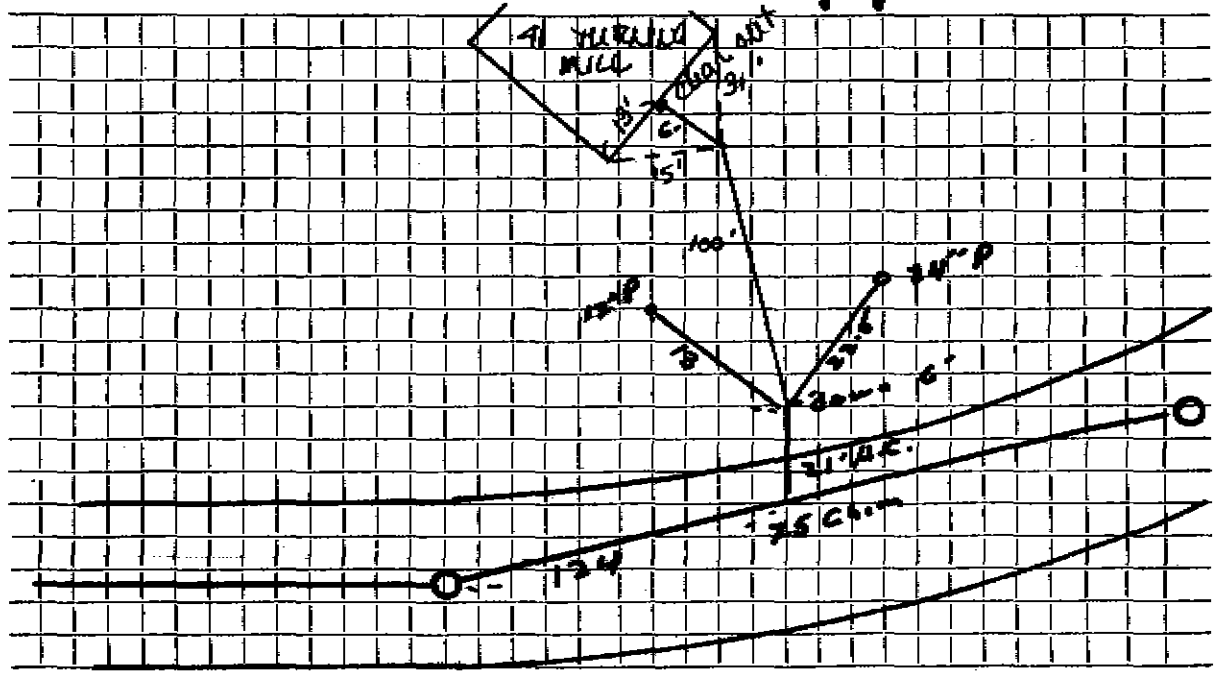

Connection made in TURNING MILL Street. Work completed 8-14-75

Remarks: .....

.....

.....