




DATE 8-14-01

TOWN OF LEXINGTON — BOARD OF PUBLIC WORKS  
SEWER DIVISION

Sketch of Service Here

43 TURNING MILL RD

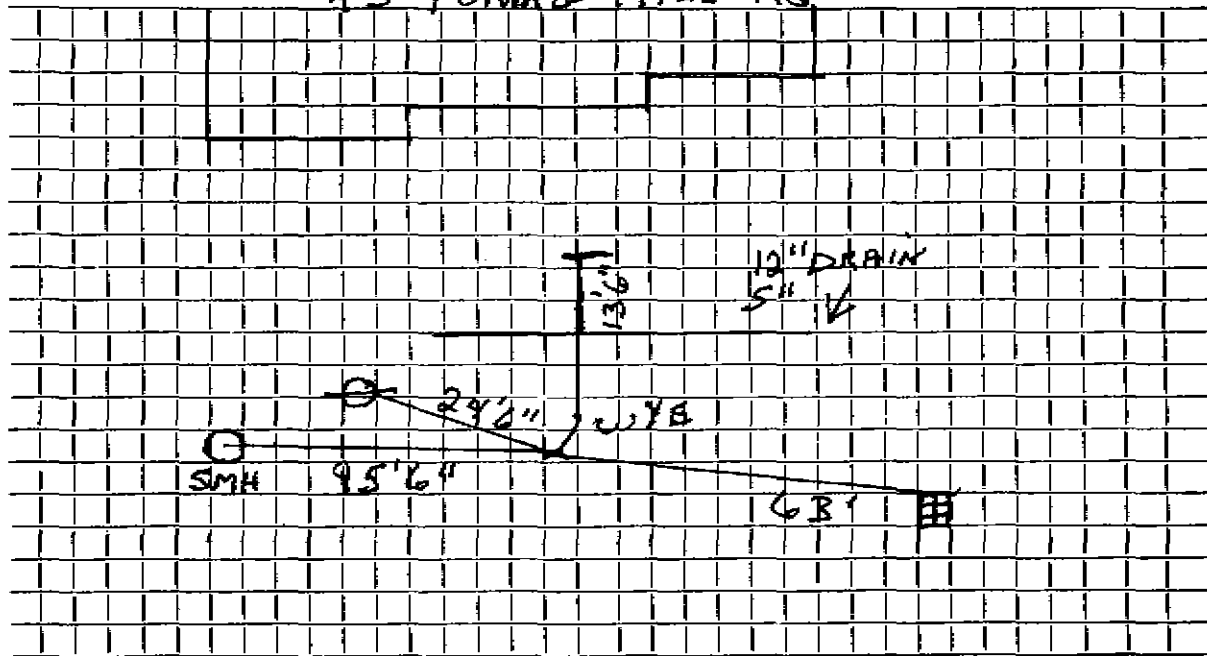

Connection made in TURNING MILL.... Street. Work completed 9-22-00.....

Remarks: INSTALLED BY NORTH SHORE CONS.....