


DATE _____

TOWN OF LEXINGTON — BOARD OF PUBLIC WORKS

SEWER DIVISION

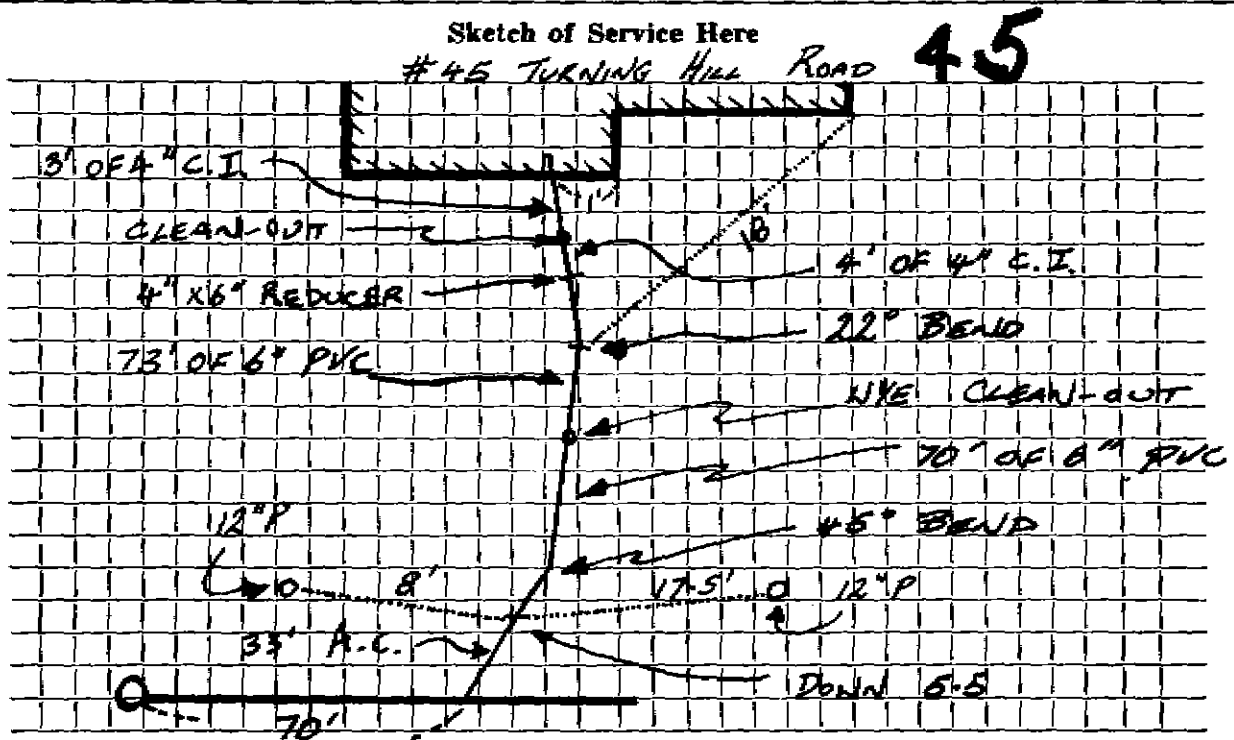

Connection made in TURNING HILL ROAD Street.

Work completed

Remarks:

.....

.....