

Name Stephen T. Russian

Service No. 85 (75)

Address 47 TURNING MILL RD.

47 TURNING MILL ROAD

Location

Kind of Pipe A.C.

Size 6"

Size of Main 8"

Repair—Renewal—New Service

Valeri #2737

Location AUG 16 1976

Date	Material	Amount	Total	Date	Amount
4/24/75	31' A.C. @ 10.00		310.00	9-2-75	310.00
10/3/75	96' 6" Transite Pipe				
	10' 4" Cast Iron Pipe				

Deposit


310.00

DATE \_\_\_\_\_

TOWN OF LEXINGTON — BOARD OF PUBLIC WORKS

SEWER DIVISION

Sketch of Service Here **47**

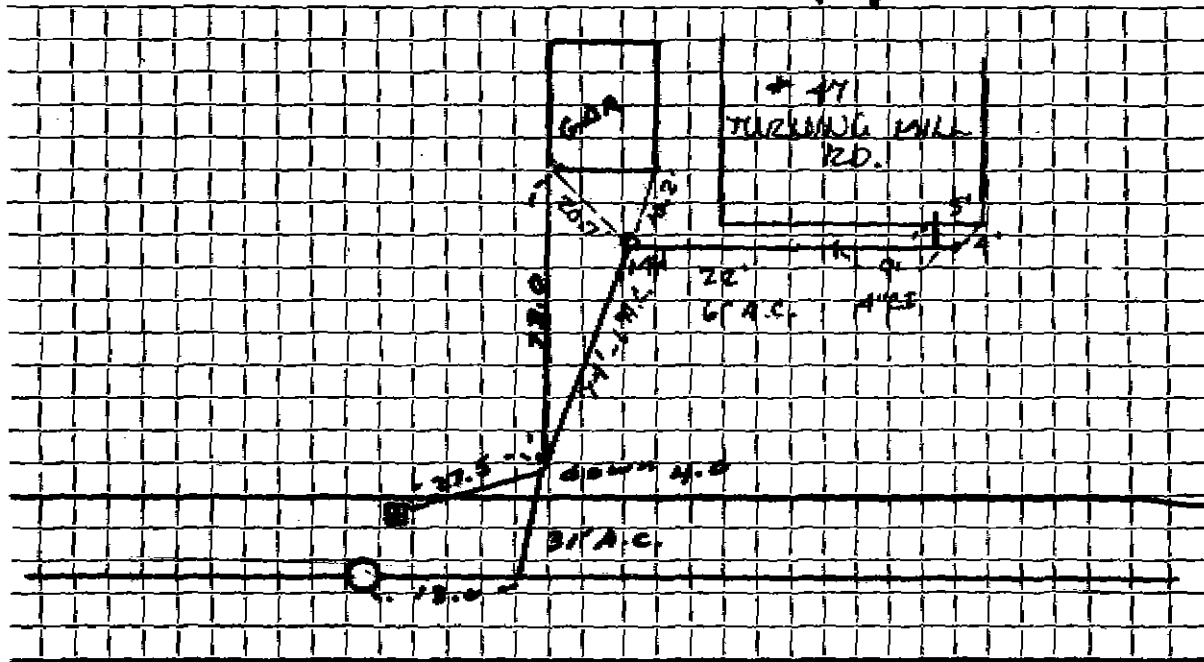

Connection made in TURNING MILL RD. Street. Work completed 9-3-75

Remarks: .....

.....

.....