

Name **Erwin F. Chernoff**

Service No. 74 (75)

Address #49 **TURNING MILL RD.**

49 Turning Mill Road.

Location

Kind of Pipe **A.C.**

Size **6"**

Size of Main **8"**

Repair—Renewal—New Service **Russell Sibley #2699**


Location **AUG 16 1976**

Date	Material	Amount	Total	Date	Amount	
4/23/75	31' A.C. @ 10.00		310 00	8-1-75	Deposit	310 00
10/23/75	35' 6" Transite Pipe					
	14' 4" Cast Iron Pipe					

.S.N. 18601

TOWN OF LEXINGTON — BOARD OF PUBLIC WORKS
SEWER DIVISION

Sketch of Service Here **49**

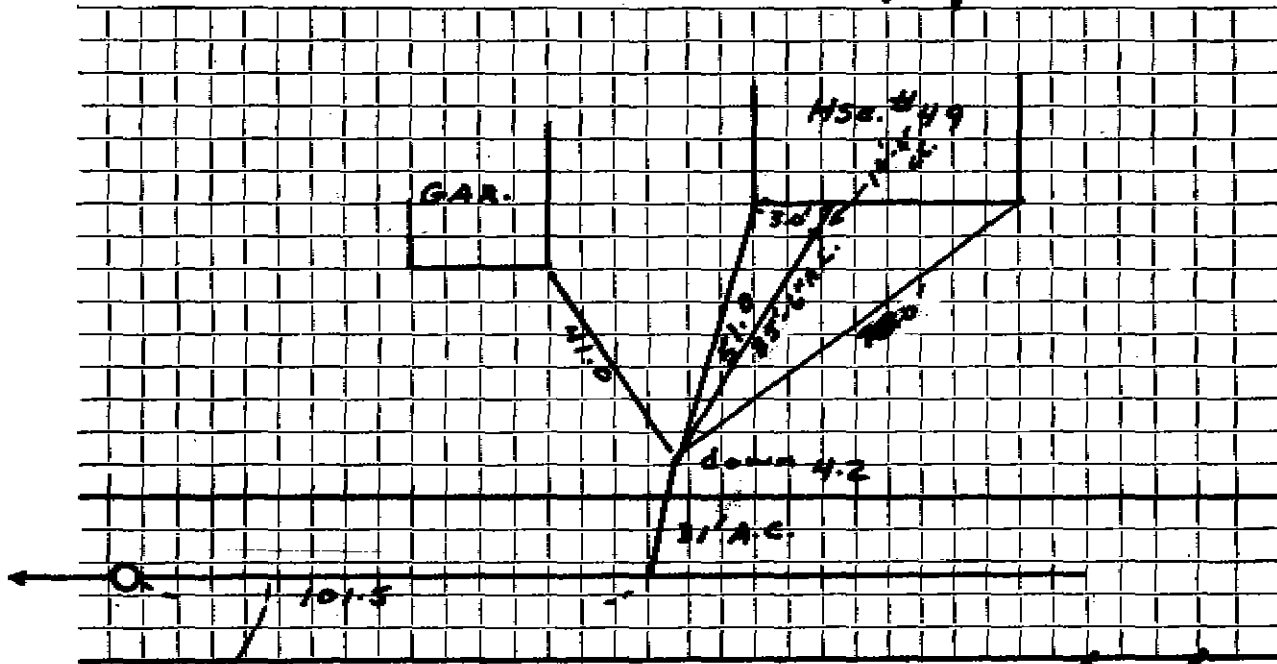

Connection made in **49 Turning Mill Street.**

Work completed **10/23/75**

Remarks: