




SEWER DIVISION

Sketch of Service Here **5**

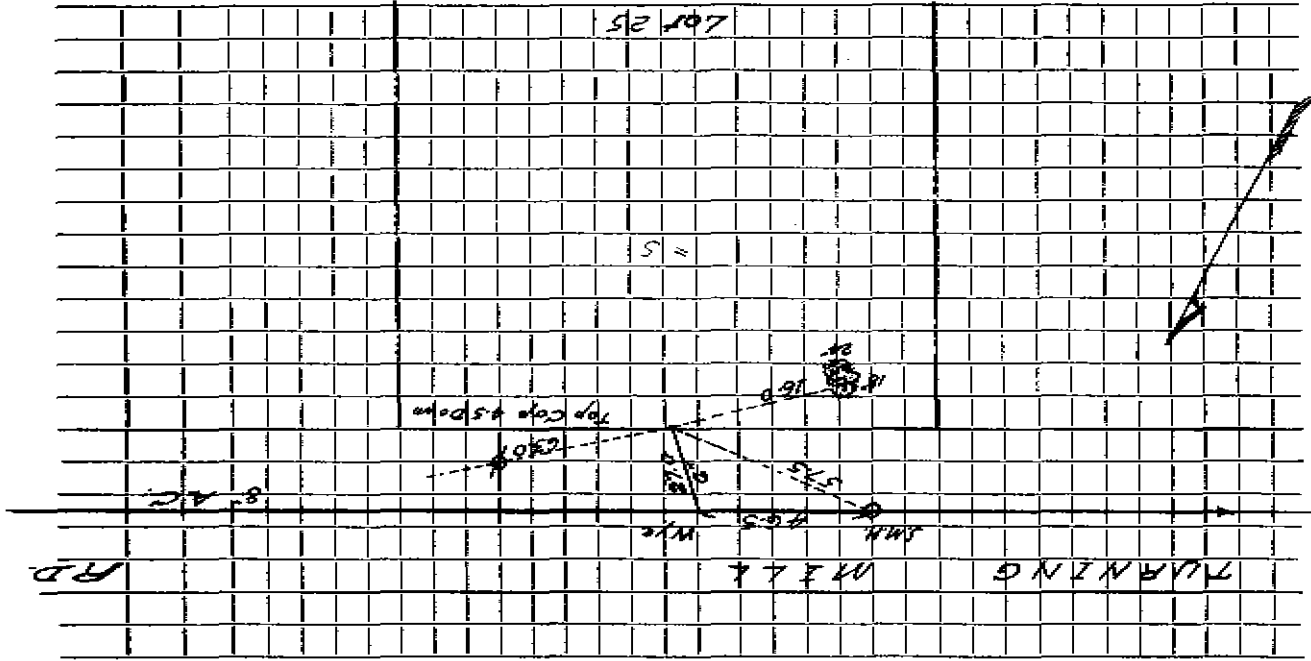

Connection made in \_\_\_\_\_ Street. Work completed \_\_\_\_\_  
 Remarks: \_\_\_\_\_