


11 11 1975

SEWER DIVISION

TOWN OF LEXINGTON — BOARD OF PUBLIC WORKS

DATE APRIL 15, 1975

Sketch of Service Here **50**

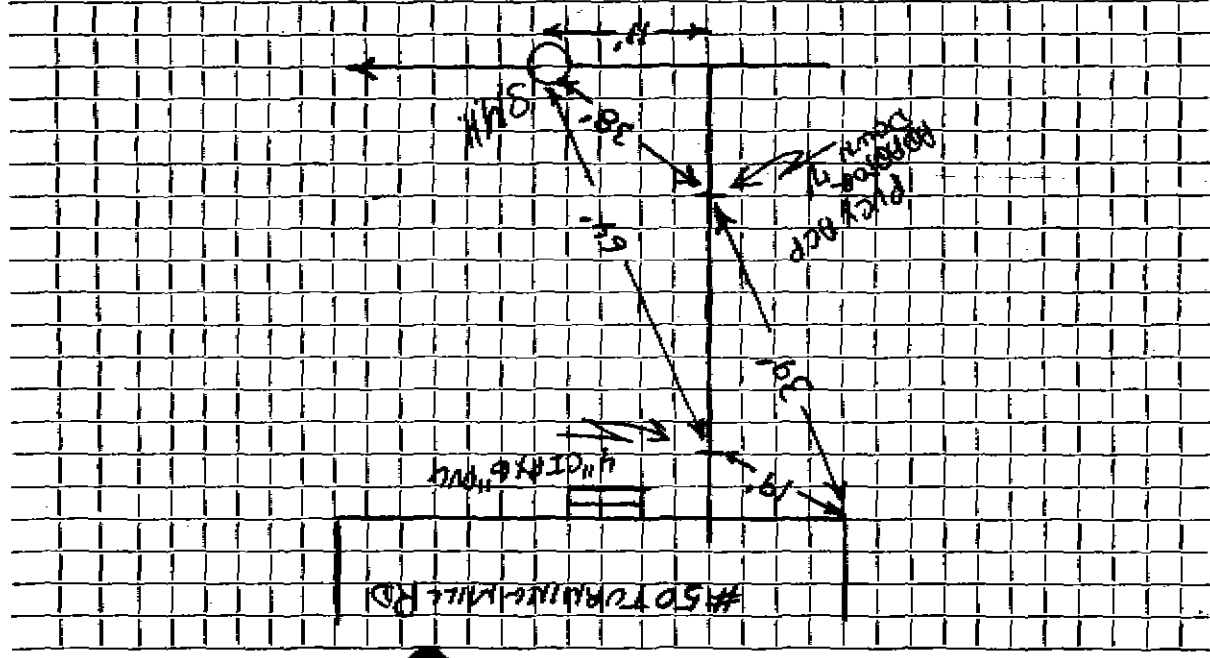

Connection made in TURNMILL ROAD Street. Work completed August 8, 1984

Remarks: