




DATE 6/7/05

TOWN OF LEXINGTON — BOARD OF PUBLIC WORKS

SEWER DIVISION

Sketch of Service Here

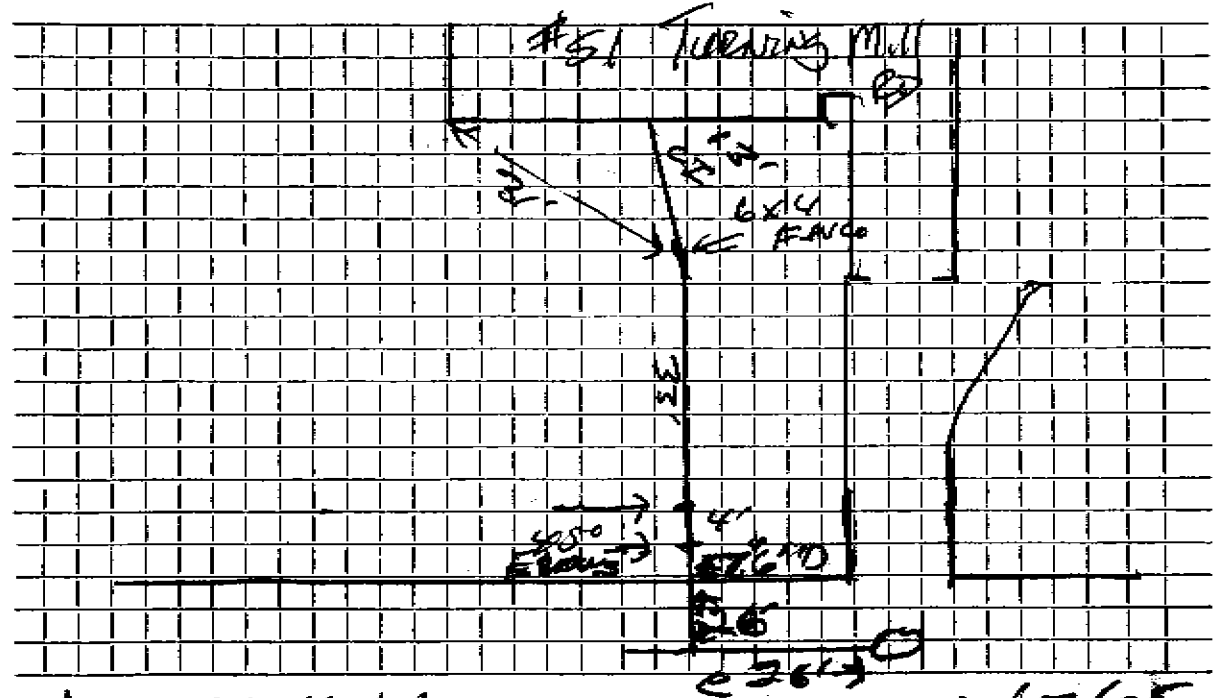

Connection made in TURNING MILL Street. Work completed 6/7/05

Remarks: Bends go straight down