


TOWN OF LEXINGTON — BOARD OF PUBLIC WORKS
DATE _____

SEWER DIVISION

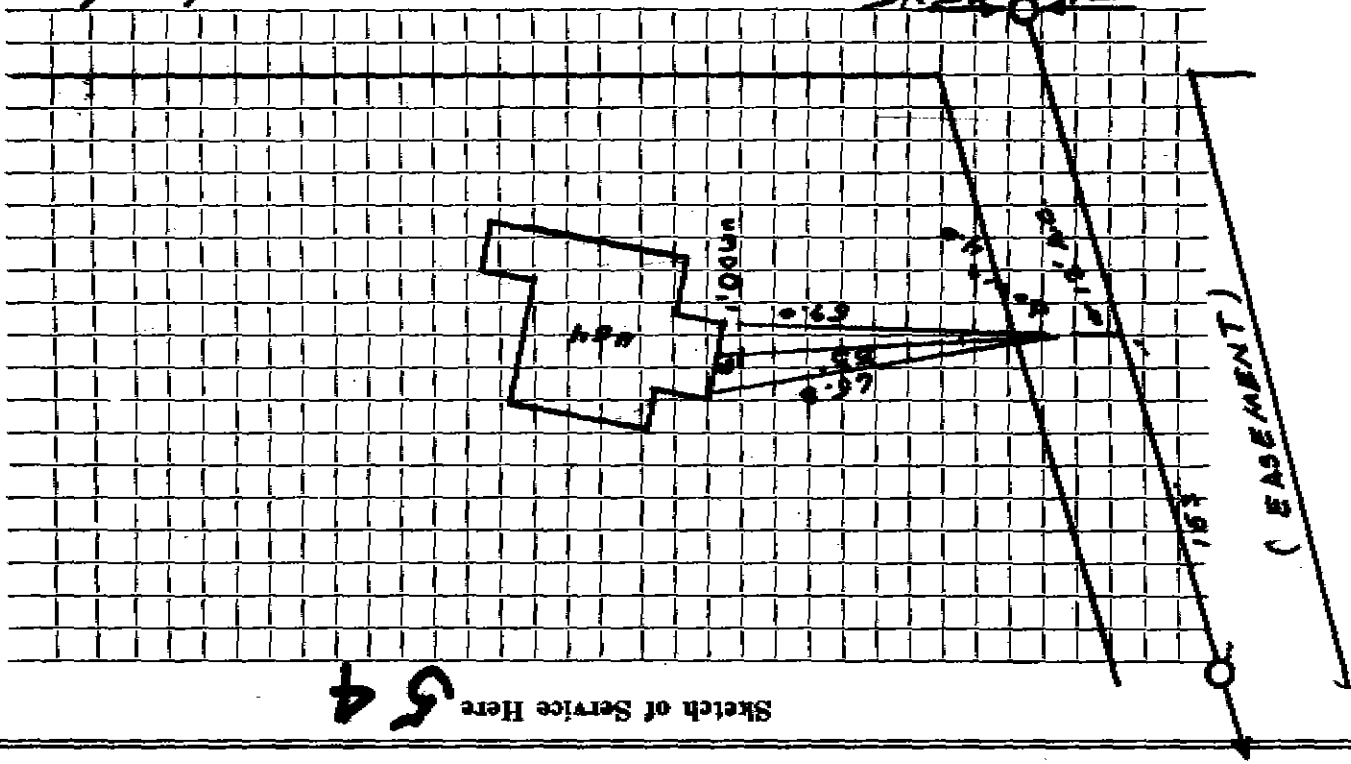

Connection made in S.W. corner of M.I.L. Street.

Work completed

8/22/75

Remarks: