

Name

Service No.

Address #55 TURNING MILL RD.

55 TURNING MILL ROAD

Location

Kind of Pipe

A.C.

Size

6"

Size of Main

8"

Repair—Renewal—New Service

Location

Date

8/24/75

Material

26' A.C. @ 10.00

Amount

Total

260.00

Date


Amount

DATE _____

TOWN OF LEXINGTON — BOARD OF PUBLIC WORKS

SEWER DIVISION

Sketch of Service Here **55**

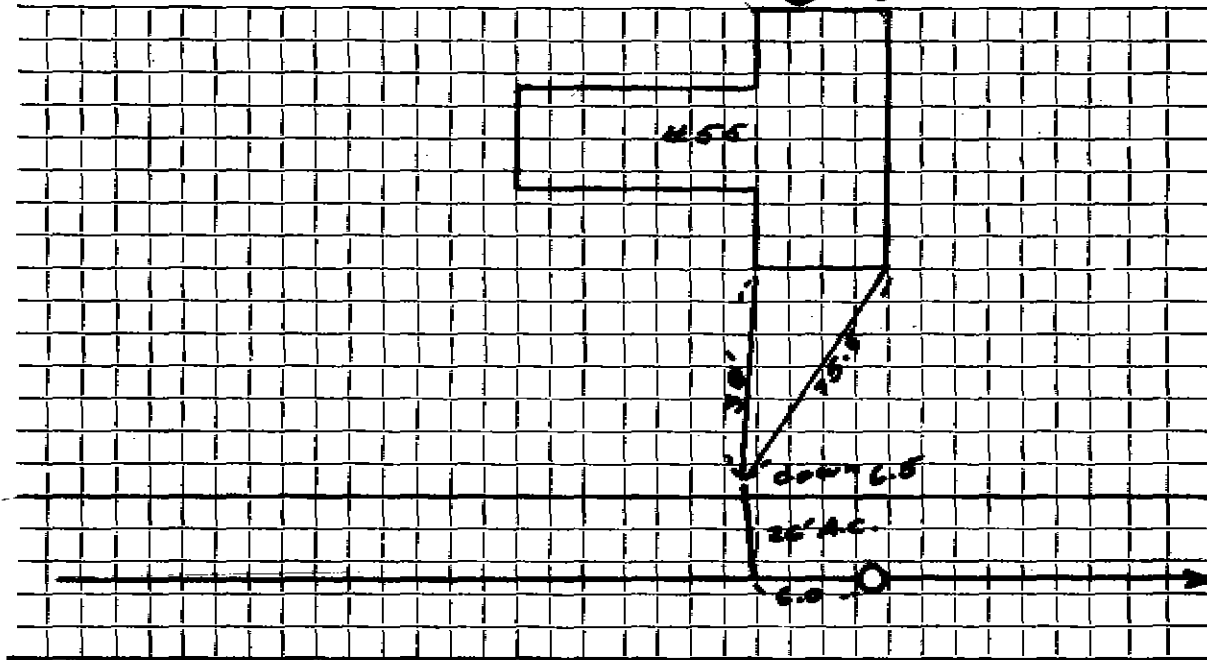

Connection made in Street. Work completed

Remarks:

.....

.....