

Name **Stannol Appliances**
 Address **56 TEANNING MILL RD.**
56 TEANNING MILL ROAD

Service No. **9**

Kind of Pipe **A.C.**

Size **6"**

Size of Main **6"**

Invoice ~~XXXXXXXXXX~~ - New Service Valued **\$343**

Location **MAY 2 6 1981**


Date	Material	Amount	Total	Date	Amount
4/23/75	27 A.C. @ ^{Price} 12.50		270 00	4-6-81	270 00
4/7/81	6" ACT			<i>Deposit</i>	
1	6" x 22 1/2" Band				
	Brick Manhole W/covers				

TOWN OF LEXINGTON — BOARD OF PUBLIC WORKS

SEWER DIVISION

DATE _____

Sketch of Service Here **56**

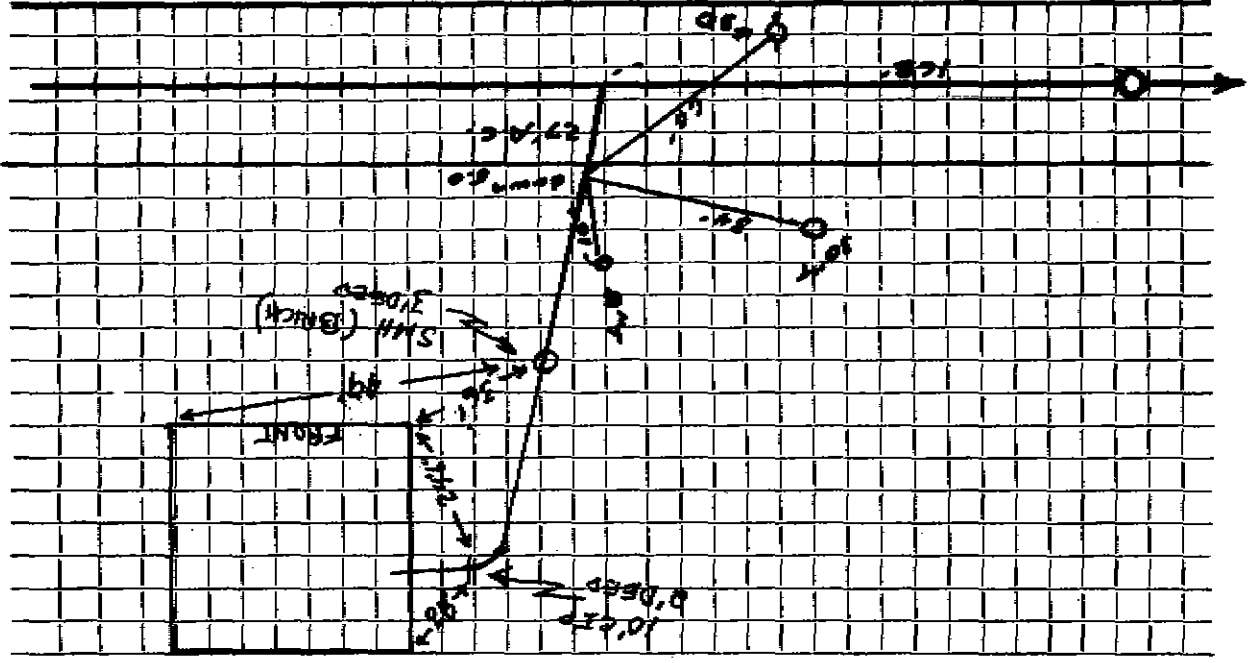

Connection made in _____

Street. _____

Work completed _____

Remarks: _____