

Service No.

Name

Address 57 TURNING MILL RD.

57 TURNING Mill Road

Location

Kind of Pipe

A.C.

Size

6"

Size of Main

0"

Repair—Renewal—New Service


Location

Date	Material	Amount	Total	Date	Amount
4/24/75	26'A.C. @ 10.00		260.00		

DATE _____

TOWN OF LEXINGTON — BOARD OF PUBLIC WORKS
SEWER DIVISION

Sketch of Service Here **57**

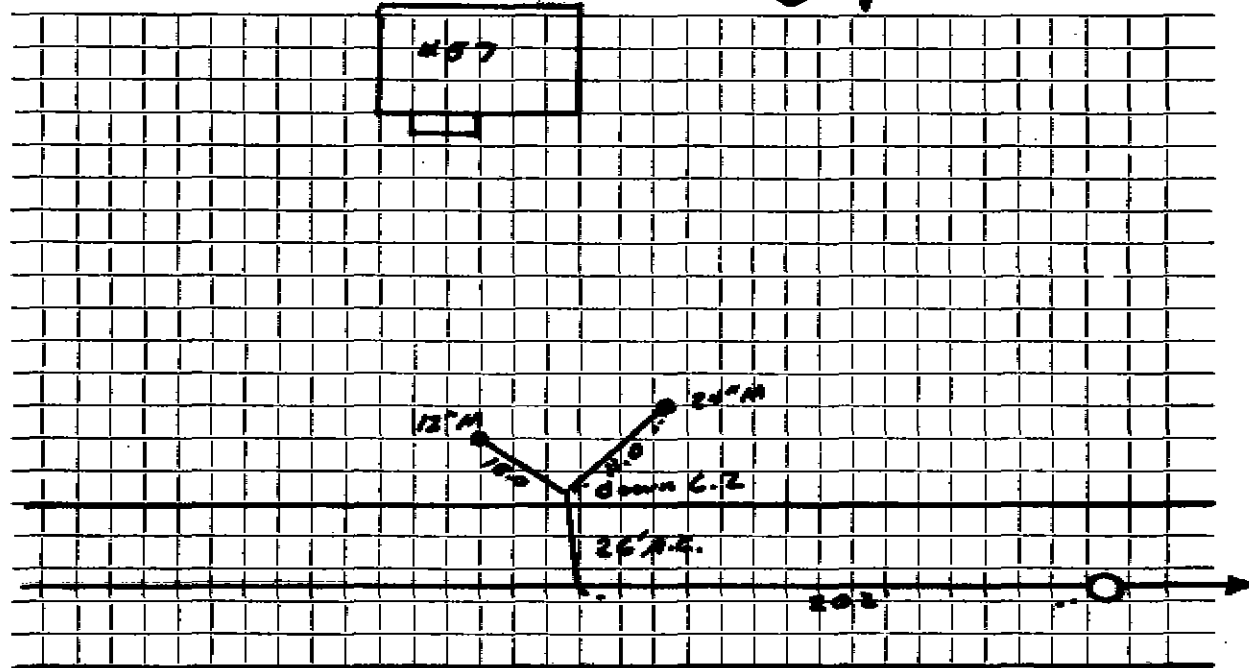

Connection made in Street. Work completed

Remarks:
.....
.....