

Name Edward Engleberg

Service No. 50

Address 58 TURNING MILL RD.

58 TURNING MILL RD.

Location

Kind of Pipe A.C.

Size C

Size of Main B

Repair—Renewal—New Service Valves #2117

Location OCT 25 1976

Date	Material	Amount	Total	Date	Amount
4/23/75	30' A.C. @ \$10.00		300 00	5-8-75	Deposit
					300 00


DATE \_\_\_\_\_

TOWN OF LEXINGTON — BOARD OF PUBLIC WORKS

SEWER DIVISION

Sketch of Service Here

58

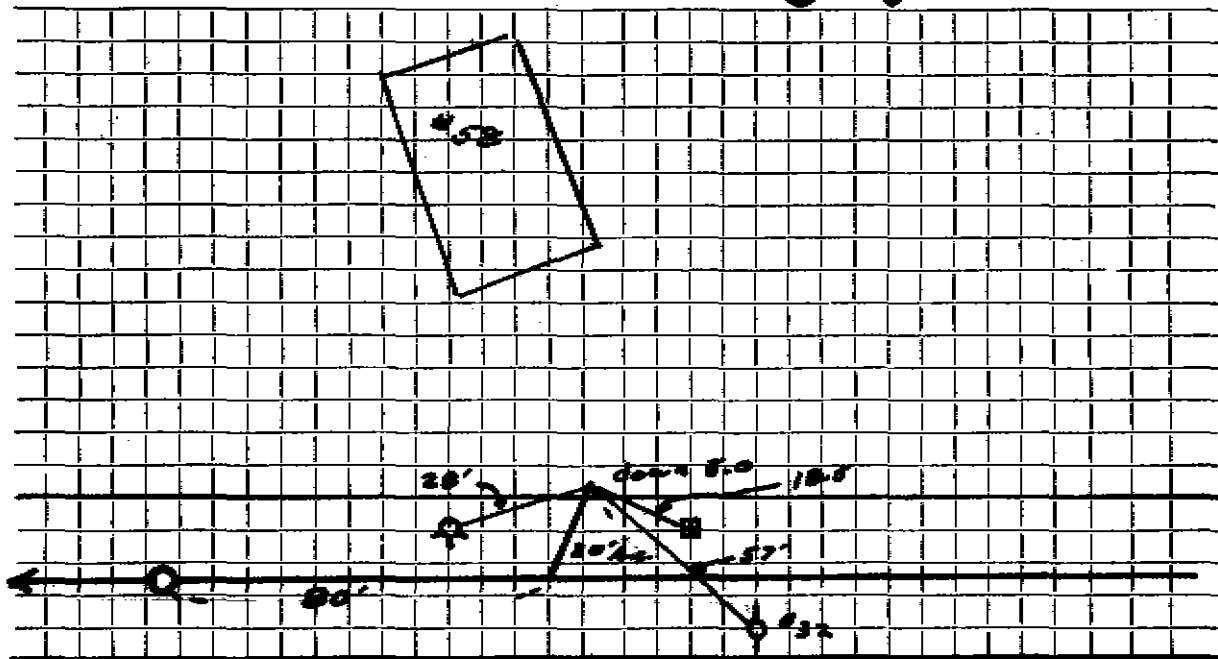

Connection made in ..... Street. Work completed .....

Remarks: .....

.....

.....