


DATE _____

TOWN OF LEXINGTON — BOARD OF PUBLIC WORKS

SEWER DIVISION

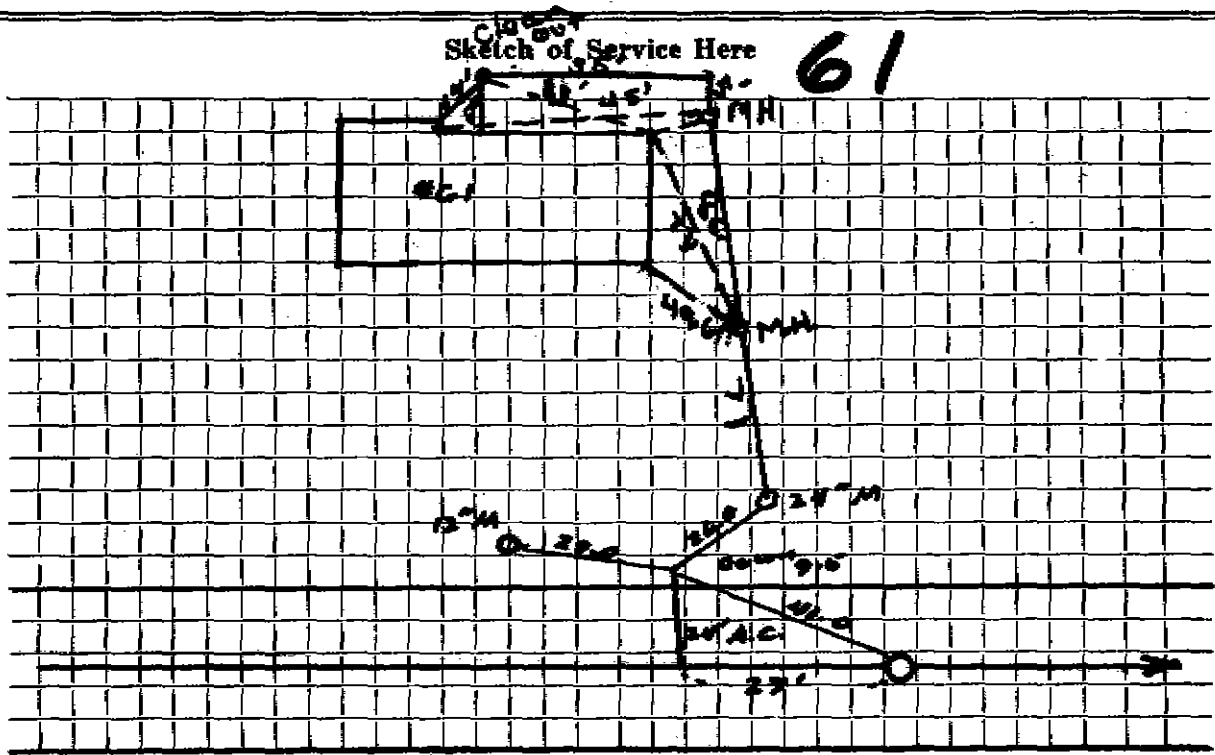

Connection made in *61 Turning Mill* Street.

Work completed *June 20, 1975*

Remarks: