

Name **Peter Glaser**

Service No.

81 (75)

Address #62 TURNING MILL RD.

62 TURNING MILL ROAD

Location

Kind of Pipe **A.C.**

Size **6"**

Size of Main **8"**

Repair—Renewal—New Service **Valeri #2733**

Location **AUG 16 1976**


Date		Material	Amount	Total	Date	Amount
4/22/75		30' A.C. ^{300.00} A.C.		300.00	8/22/76	Deposit 300.00
8/27/75	78'	6" Transite Pipe				
	7'	4" Cast Iron Pipe				

DATE _____

TOWN OF LEXINGTON — BOARD OF PUBLIC WORKS

SEWER DIVISION

Sketch of Service Here **62**

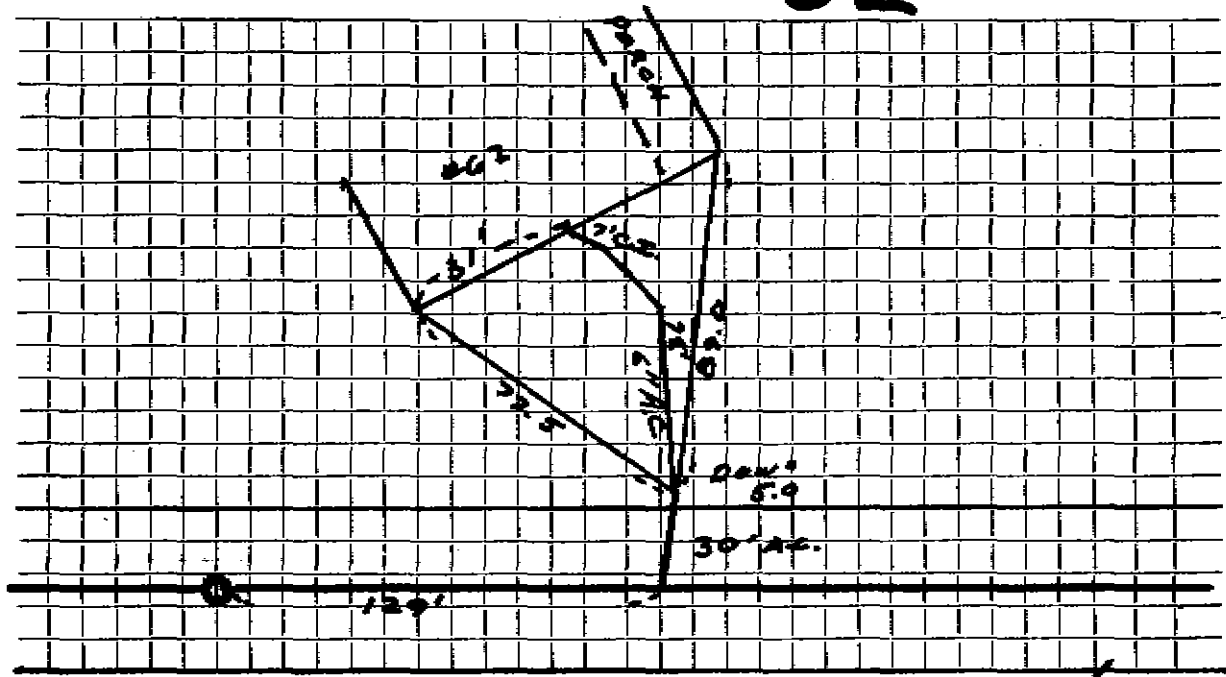

Connection made in #62 Turning Mill Street.

Work completed 8/27/75

Remarks:

.....

.....