

Name Donald M. Shaw

Service No.

97(75)

Address "64 TURNING MILL RD.

64 TURNING MILL ROAD

Location

Kind of Pipe A.C.

Size 6"

Size of Main 8"

Repair—Renewal—New Service

Valeri Const. #2912


Location AUG 16 1976

Date	Material	Amount	Total	Date	Amount
4/22/75	29' A.C. @ <del>10.00</del> <sup>10.00</sup>		290 00	7/25/75	Deposit 290 00
10/1/75	78' 6" Transite Pipe				
	15' 4" Cast Iron Pipe				

DATE \_\_\_\_\_

TOWN OF LEXINGTON — BOARD OF PUBLIC WORKS  
SEWER DIVISION

Sketch of Service Here **64**

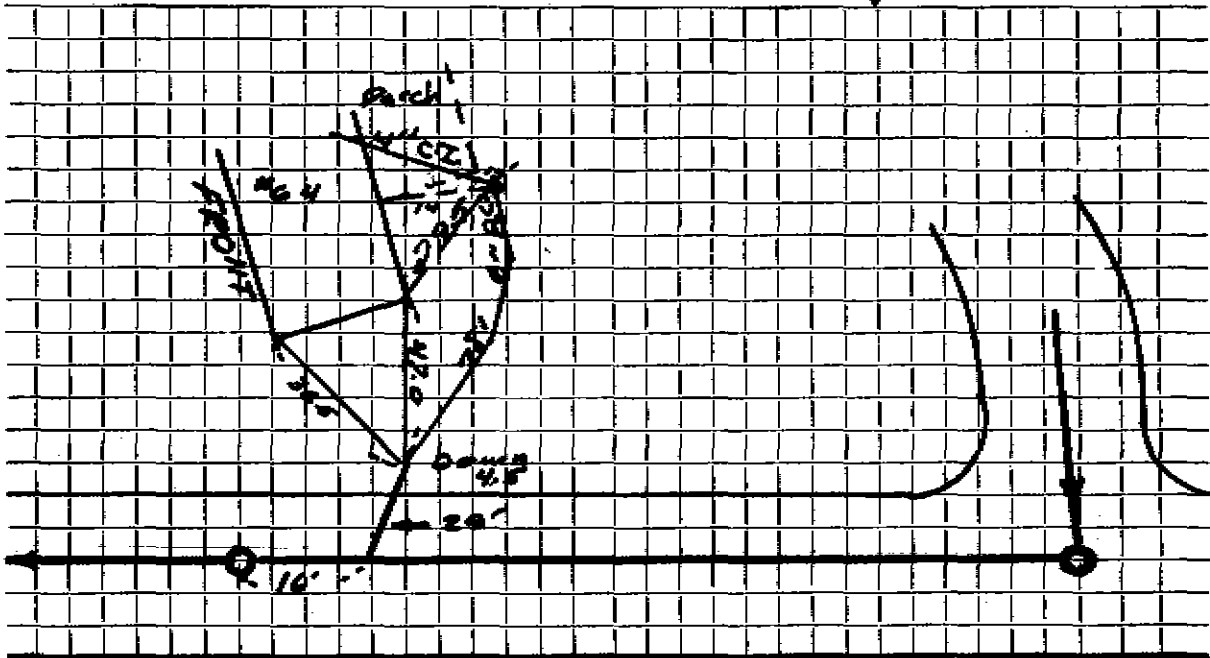

Connection made in *G.Y. Turning Mill* Street.

Work completed *10/1/1975*

Remarks: .....