

Name

Service No.

Address **67 TURNING MILL RD.**

**67 TURNING MILL ROAD**

Location

Kind of Pipe

**A.C.**

Size

**6"**

Size of Main

**8"**

Repair—Renewal—New Service

Location


Date	Material	Amount	Total	Date	Amount
4/23/75	40'A.C. @ 10.00		400.00		

TOWN OF LEXINGTON — BOARD OF PUBLIC WORKS

SEWER DIVISION

DATE \_\_\_\_\_

Sketch of Service Here **67**

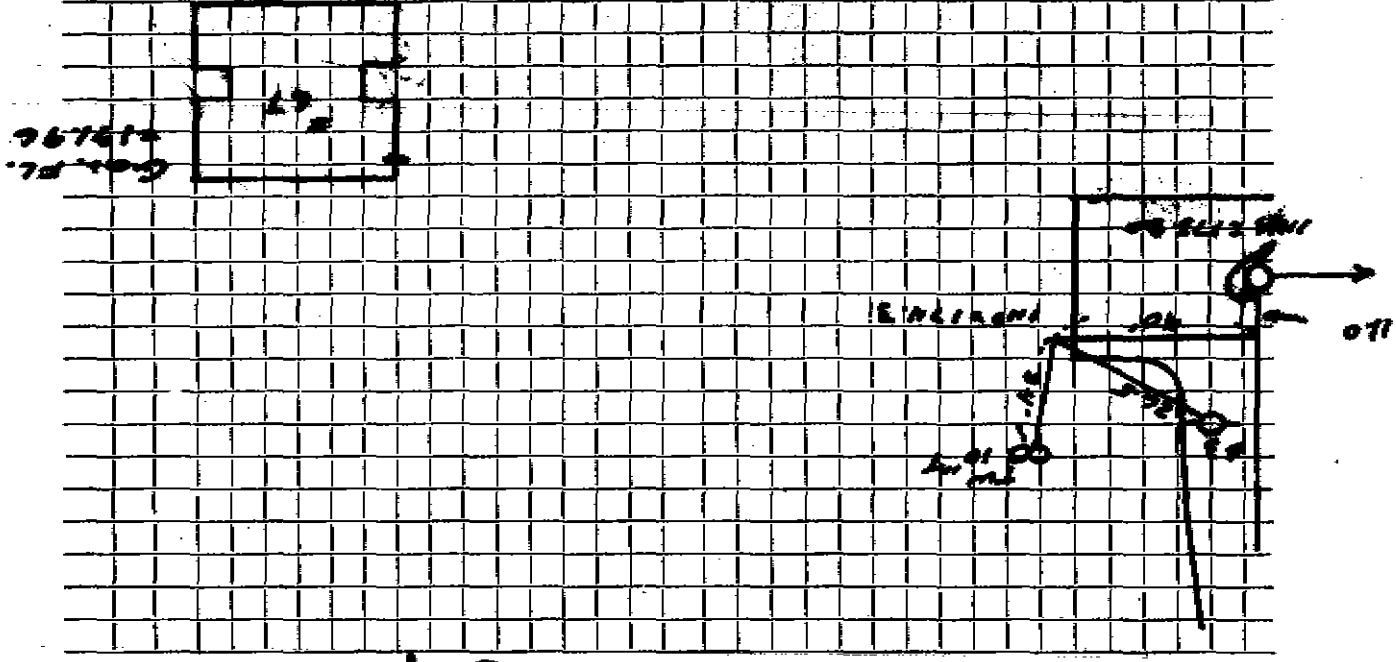

Connection made in \_\_\_\_\_

Street \_\_\_\_\_

Work completed \_\_\_\_\_

Remarks: \_\_\_\_\_

CON. PL.  
11/1/96