

Name Walter F. Stern

Service No. 161

Address

7 Turning Mill Rd. Lot 24

7 Turning Mill Road

Location

Kind of Pipe

Size 6"

Size of Main 8"

Repair—Renewal—New Service Valeri #842

Location MAR 18 1968

Date	Material	Amount	Total	Date	Amount
1967	141' 6" Transit pipe @ 7.00		168.00	11-10-67	Deposit 168.00
11-14-67	114' 6" Transit pipe				
	11' 4" Cast Iron pipe				
	24 @ 7				


DATE _____

TOWN OF LEXINGTON — BOARD OF PUBLIC WORKS

SEWER DIVISION

Sketch of Service Here

7

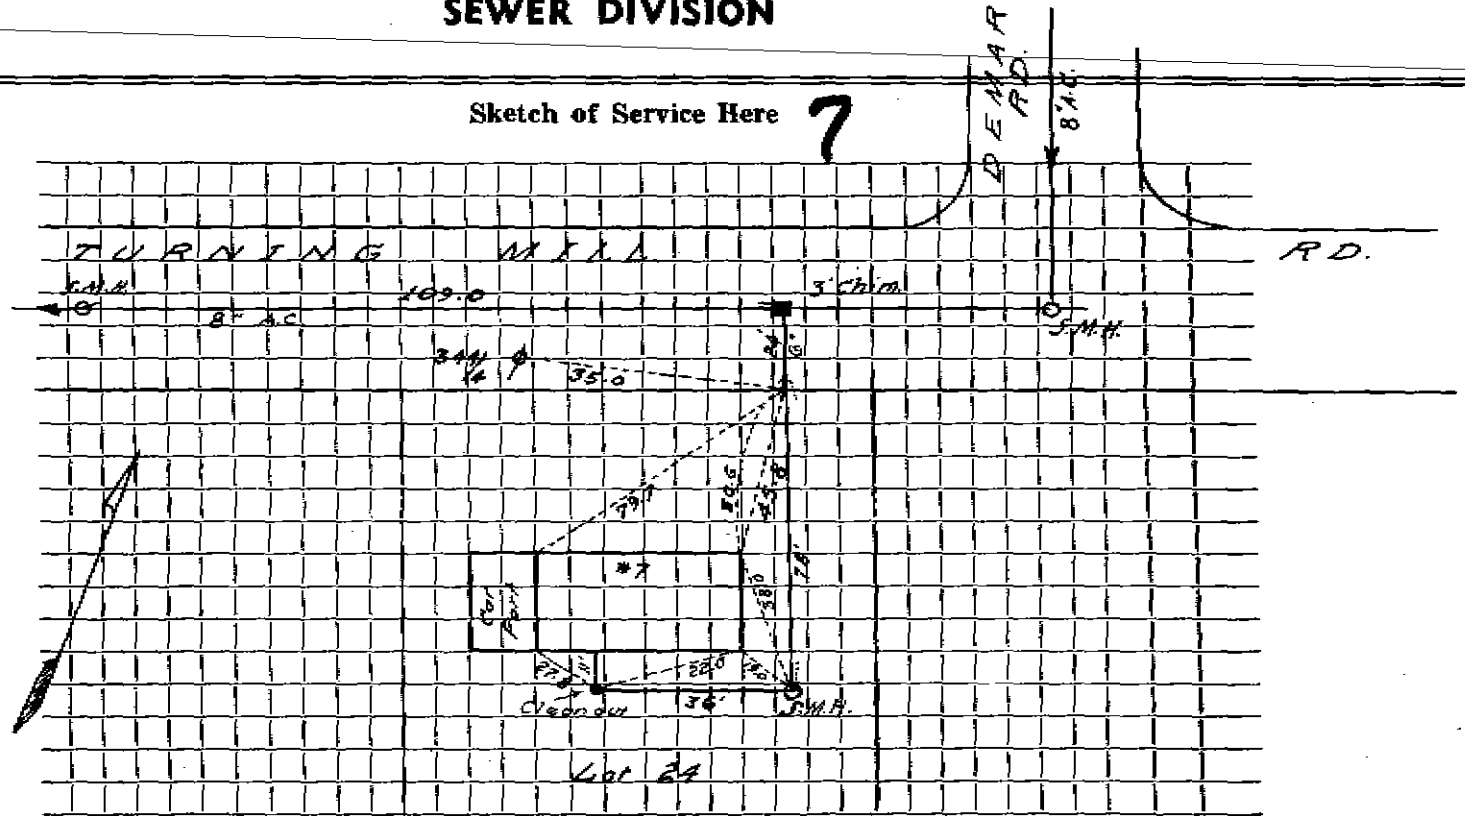

Connection made in Street. Work completed

Remarks:

.....

.....