


DATE 4/24/19

TOWN OF LEXINGTON — BOARD OF PUBLIC WORKS
SEWER DIVISION

Sketch of Service Here

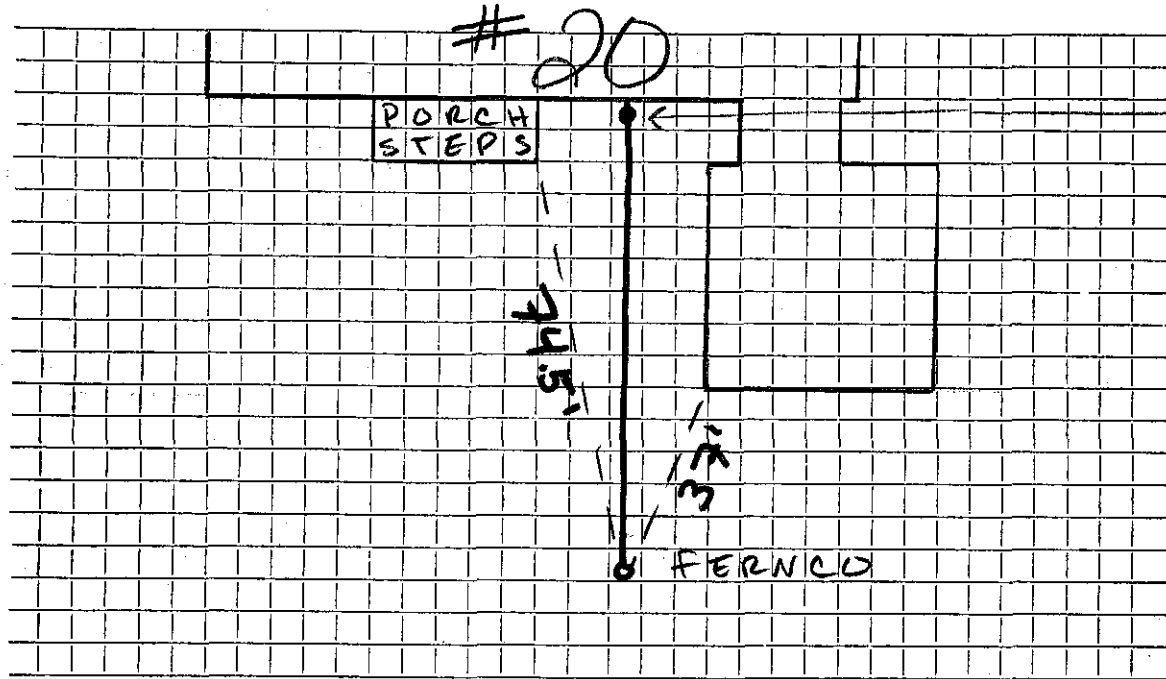

CLEANOUT
8' from
steps
against
foundation.

Connection made in Tyler Rd Street. Work completed

Remarks: Water Service @ curb stop runs above the sewer service crossing once near FernCo.