


DATE Aug. 2018

TOWN OF LEXINGTON — BOARD OF PUBLIC WORKS

SEWER DIVISION

Sketch of Service Here

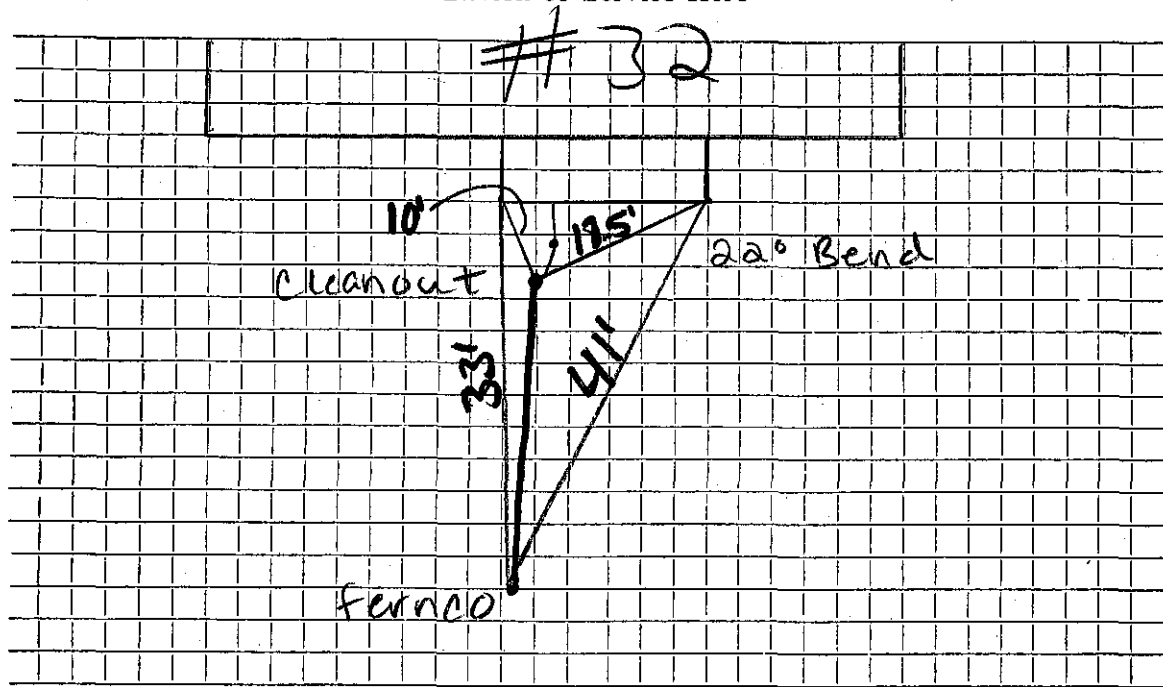

Connection made in Tyler Road Street. Work completed

Remarks:
.....
.....