




DATE

TOWN OF LEXINGTON — BOARD OF PUBLIC WORKS

Street works  
10/13/2021  
private property  
12/2/2021

SEWER DIVISION

Sketch of Service Here

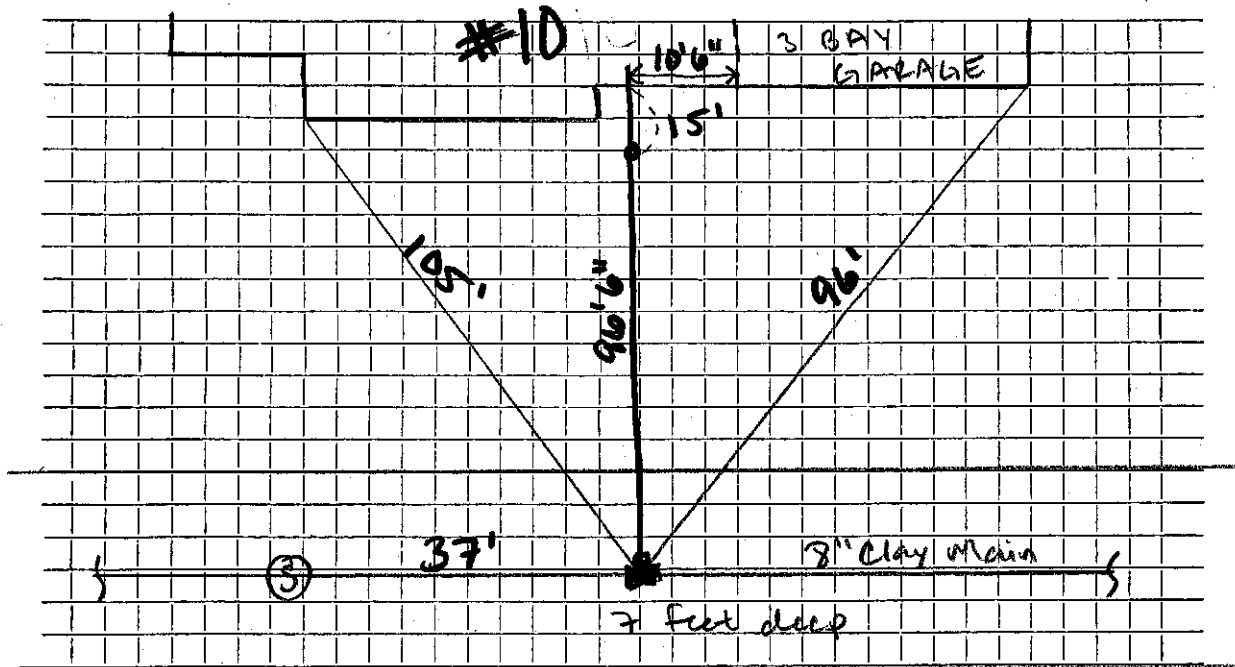

Connection made in Tyler Rd Street. Work completed .....

Remarks: .....