


DATE 06/20/24

TOWN OF LEXINGTON — BOARD OF PUBLIC WORKS
SEWER DIVISION

Sketch of Service Here
15 TYLER RD

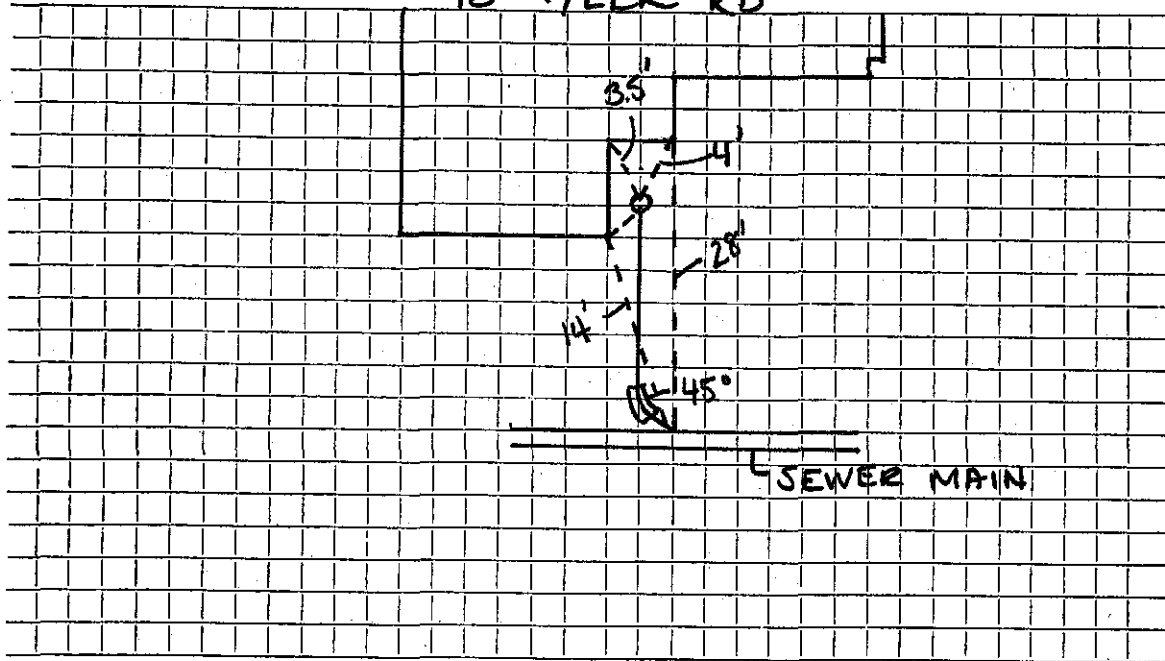

Connection made in Street. Work completed

Remarks: Installed by Uticon

