


DATE _____

TOWN OF LEXINGTON — BOARD OF PUBLIC WORKS
SEWER DIVISION

Sketch of Service Here

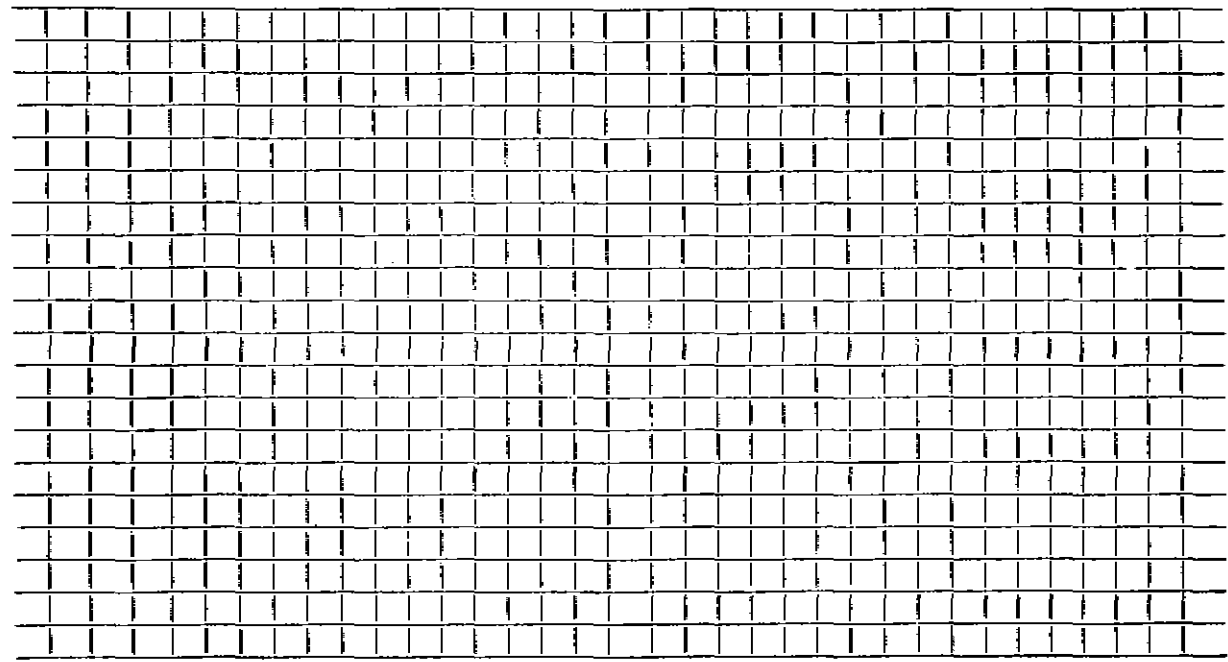


Connection made in Street. Work completed

Remarks:
.....
.....

Labor

Sketch of Service Here

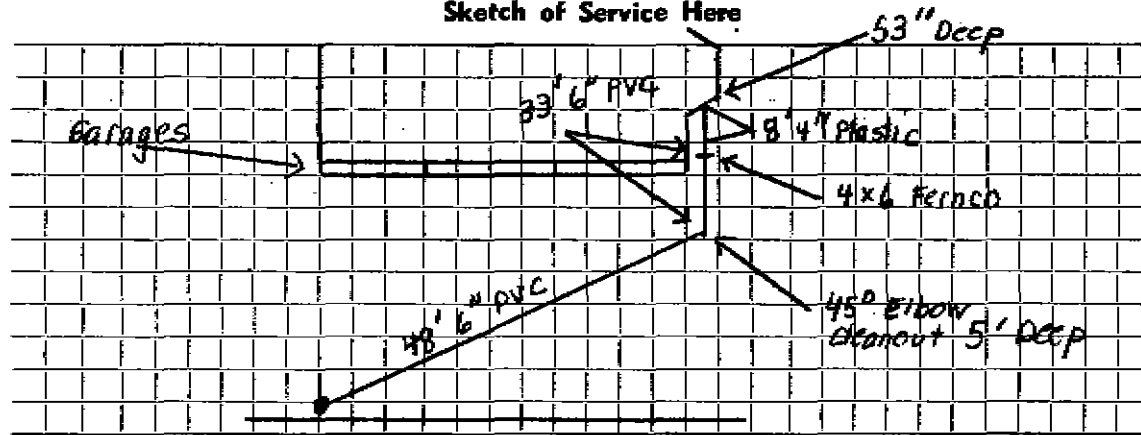

Connection made in Tyler Rd Street Work completed 19.....

Remarks: