

Name

Service No. 2321

Address # 2 Tyler Rd

Location

Kind of Pipe PVC + clay

Size 6"

Size of Main 8"

Repair—Renewal—New Service

J. McClaughlin

Location


Date	Material	Amount	Total	Date	Amount
11/15/06	6' 4" Sch 40 PVC				
75'	6" PVC				
1	4x6 Fence				
1	6" clay + PVC Fence w/ 1 1/4 bend				
1	8' 6" DOWN				
1955	Excav				
	Clay Pipe				
	(water away)				

TOWN OF LEXINGTON — BOARD OF PUBLIC WORKS

SEWER DIVISION

DATE \_\_\_\_\_

Sketch of Service Here

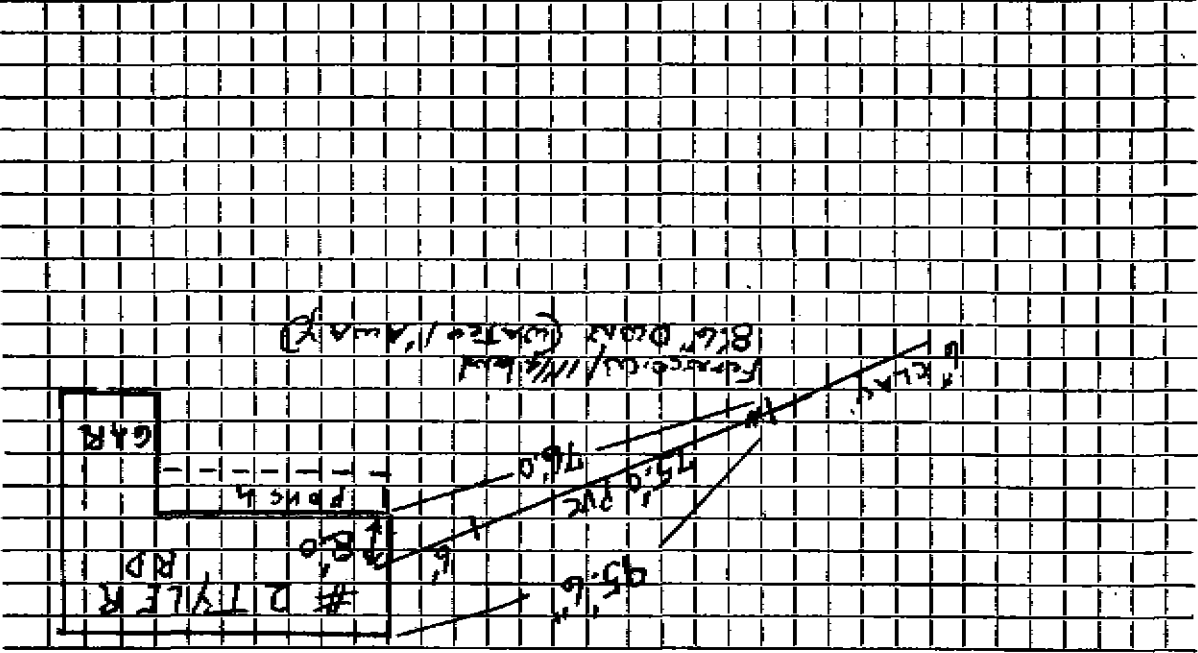

Street.

Connection made in

Remarks: *Exit to street, 1' away from sewer.*

Work completed

*11/15/06 J. McLaughlin*