

Name

Service No.

Address

23 Tyler Road

23 Tyler Road

Location

Kind of Pipe

PVC

Size 6"

Size of Main 8"

Repair ~~Renewal~~ New Service

Inside


Location

Date	Material	Amount	Total	Date	Amount
7-20-07	1-22° Bend 63' PVC 1-Fern. PVC to Tran.				
					<u>OUTSIDE</u>
				7/15/71	Labor 32 56
				7/16/71	" 174 08
				7/19	" 35 02
				7/28/71	" 30 82
				58'	6" Transite pipe .90 52 20
				1	6"x6" Nipple 1 28
				1	Saddle 5 50
				1	Donut 2 65
				1	Bag cement 1.90 95
				1	Tgn cold patch hot top 8 00
				6	7 45
				6	Yds. Loam 3.50 21 00
				25	Lbs Seed 1.10 27 50
				4	Hrs. Trucking 3.00 12 00
				1	1.50 75
				3½	Hrs. Shovel 4.00 14 00
				1	Hr. Loader 4.00 2 00
				1	" Roller 2.00 1 00
					Trailer 2 00
					430 76
				2-18-71	Solids 42'-48' out

DATE \_\_\_\_\_

TOWN OF LEXINGTON — BOARD OF PUBLIC WORKS  
SEWER DIVISION

Sketch of Service Here

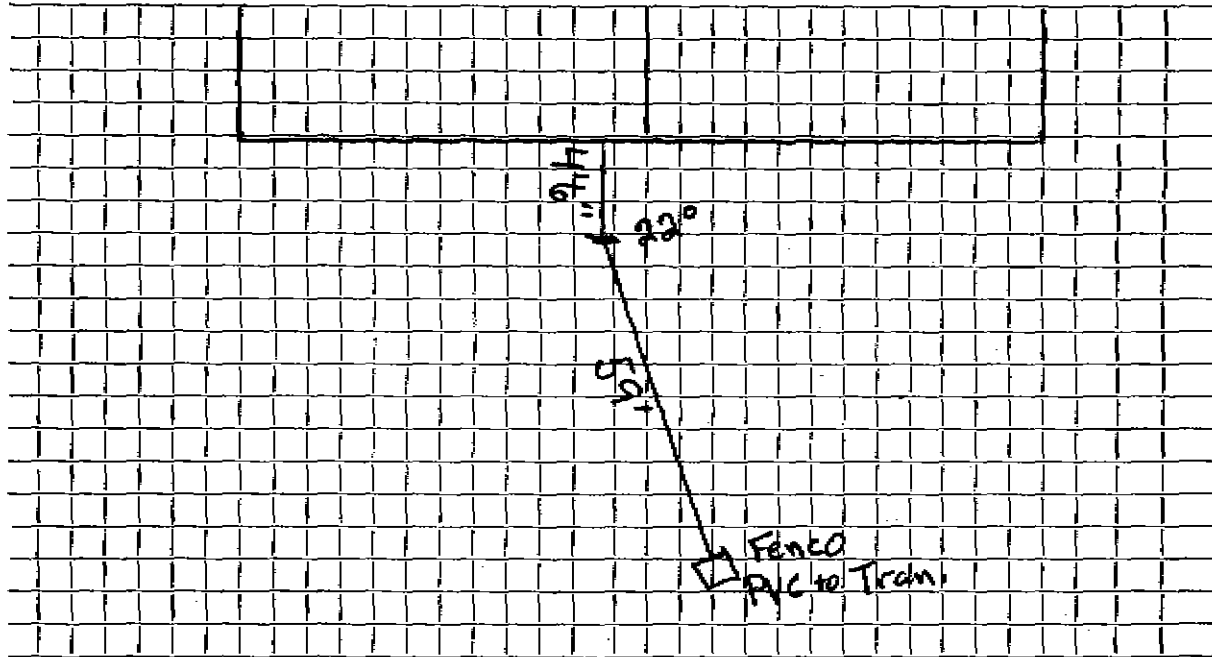

Connection made in ..... Street. Work completed .....

Remarks: .....

.....

.....