




DATE \_\_\_\_\_

**TOWN OF LEXINGTON — BOARD OF PUBLIC WORKS**  
**SEWER DIVISION**

Sketch of Service Here

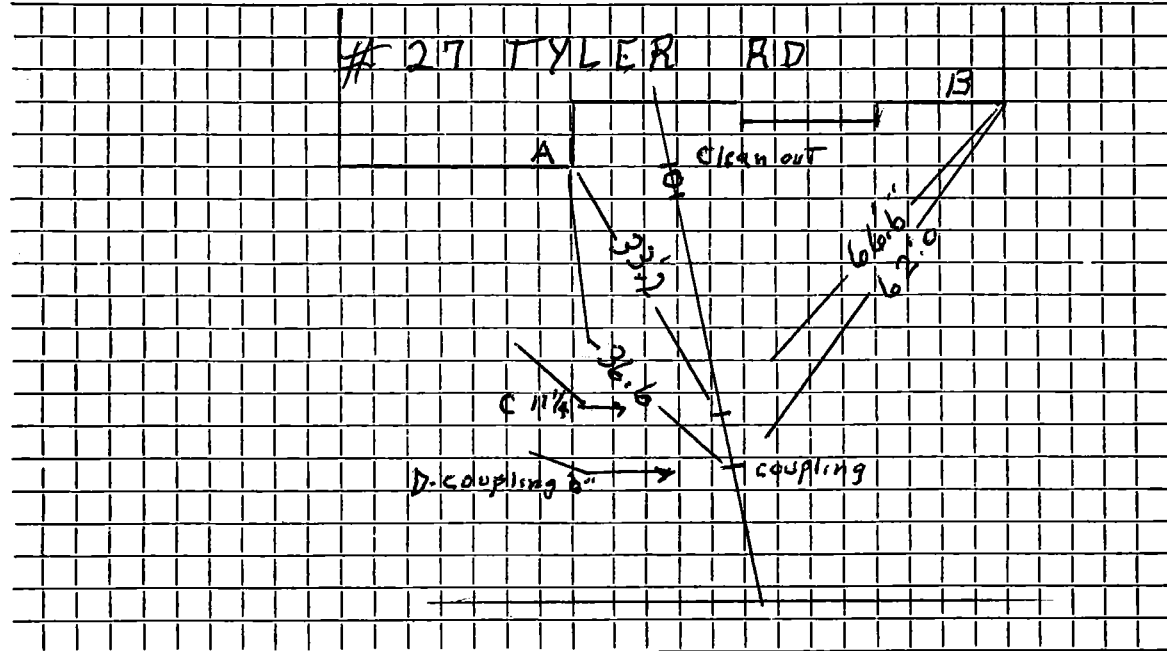

Connection made in ..... Street. Work completed 10/27/10 .....

Remarks: No. Info-out side 1956 inst. by develop. .....

.....

.....