

Name

Service No.

Address

35 Tyler Rd

Location

Kind of Pipe

Size

Size of Main

Repair—Renewal—New Service

Location

Date

Material

Amount

Total

Date


Amount

2/25/64

78' 6" PVC

SEWER DIVISION

Sketch of Service Here

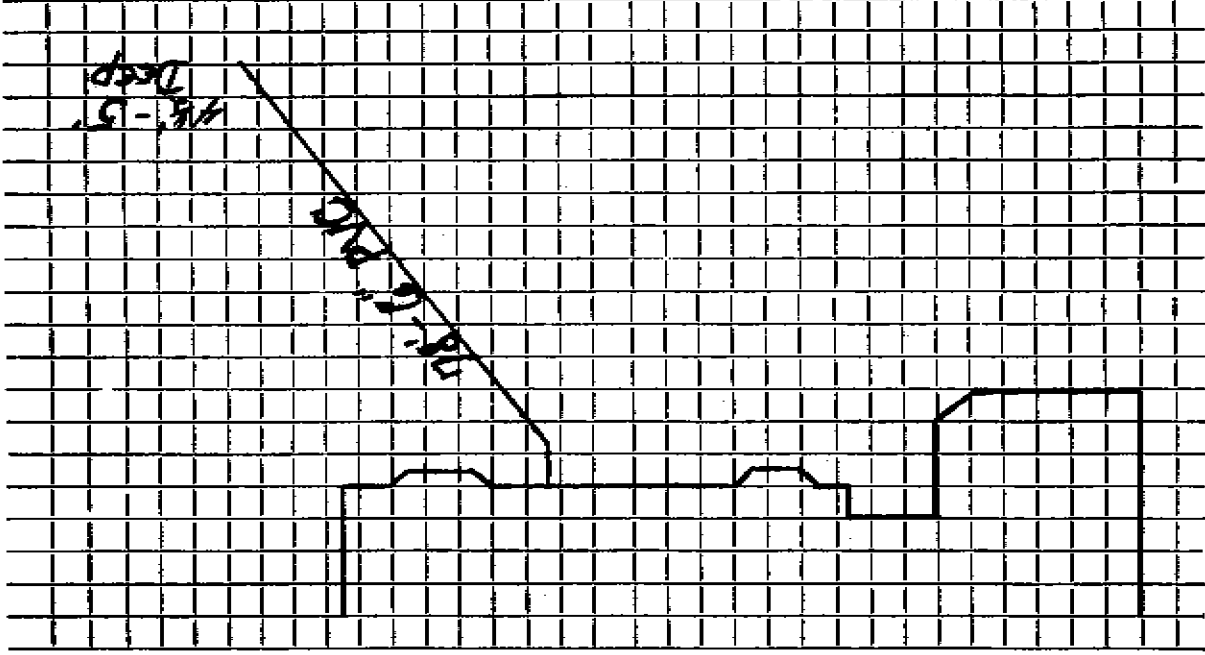

Work completed

Street

Connection made in

Remarks: