


DATE DECEMBER 10, 1996

TOWN OF LEXINGTON — BOARD OF PUBLIC WORKS
SEWER DIVISION

Sketch of Service Here

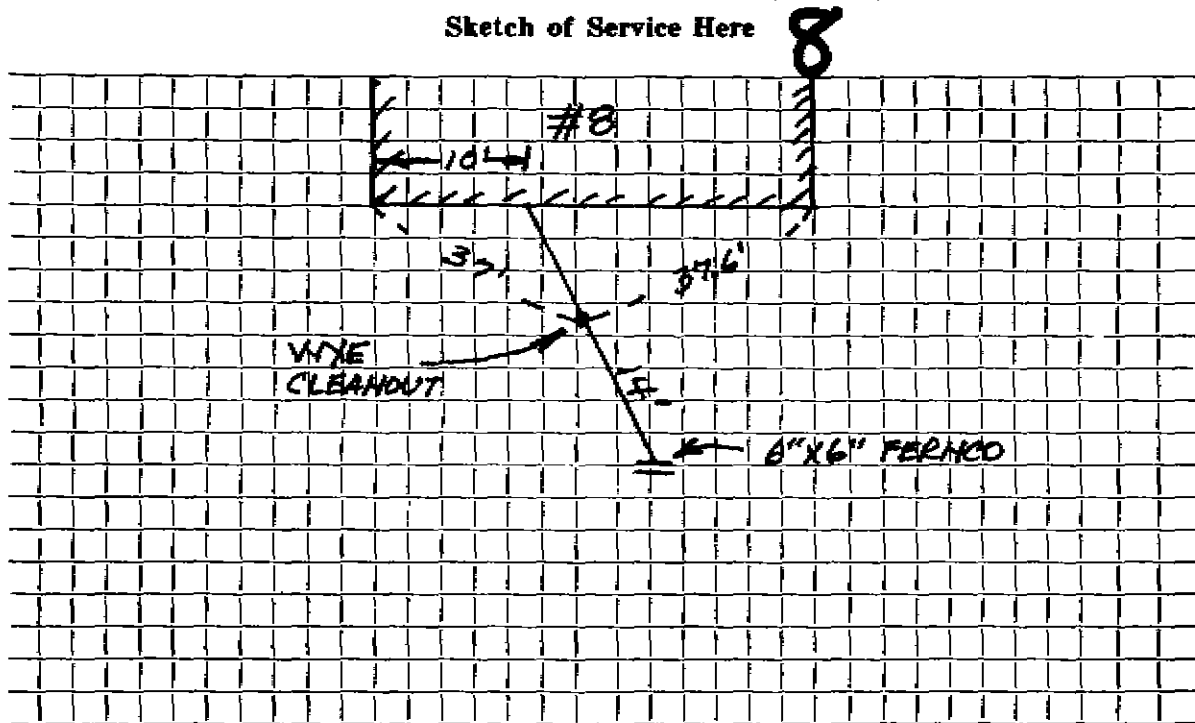

Connection made in TYLER ROAD Street. Work completed ROCKWELL CONSTRUCTION

Remarks: