




DATE 8/28/19

TOWN OF LEXINGTON — BOARD OF PUBLIC WORKS  
SEWER DIVISION

Sketch of Service Here

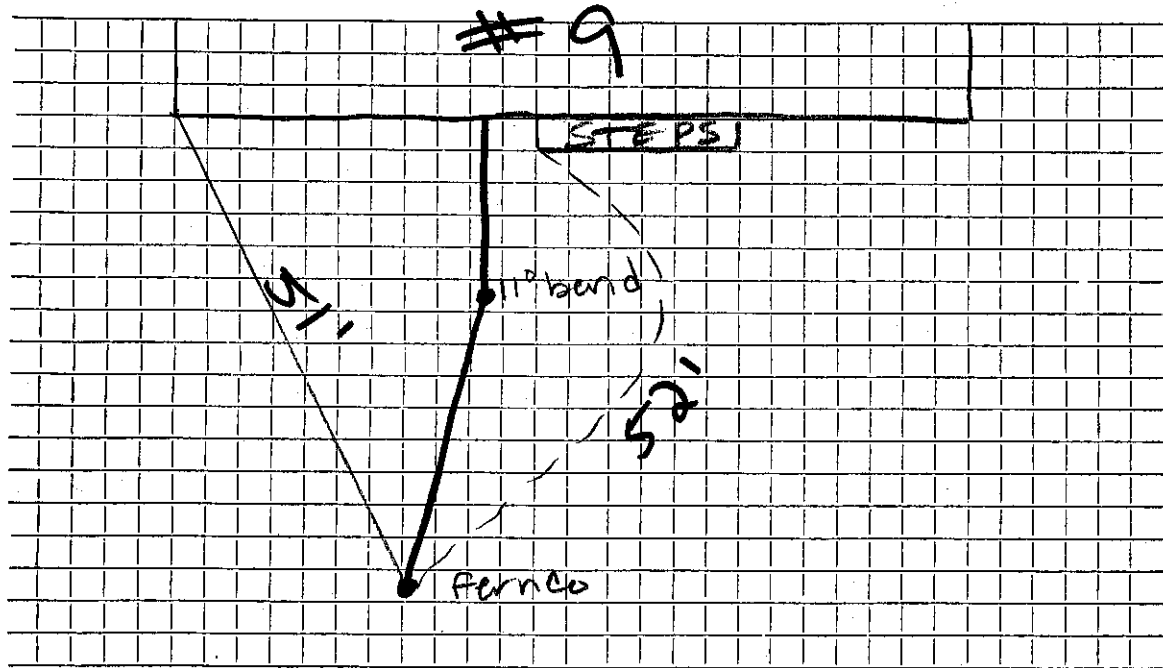

Connection made in Tyler Rd Street. Work completed .....

Remarks: length = 281  
.....  
.....