

Name *Megan Shadley*

Service No.

Address *unknown*

Contractor: *unknown*

Location

Kind of Pipe

Size

Size of Main

Repair—Renewal—New Service

Location

Date

Material

Amount

Total

Date

Amount

1/14/2019

6" clean out

1

45° Bends

2

investigation/work


DATE unknown

TOWN OF LEXINGTON — BOARD OF PUBLIC WORKS

Drawn 1/14/2019

SEWER DIVISION

Sketch of Service Here

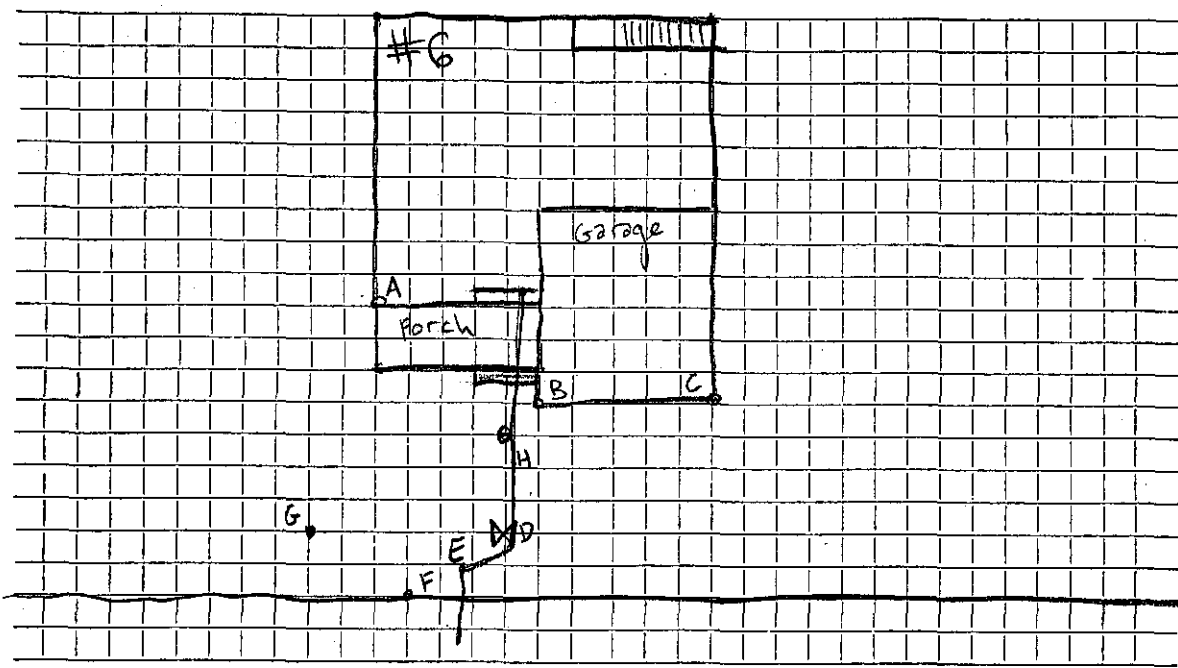

- H = 6" clean out
- D = 45° Bend
- E = 45° Bend (existing connection)
- AH = 20.8'
- BH = 4.5'
- AD = 34.5'
- BD = 25'
- AE = 39.4'
- BE = 37.5'
- D_{connect} = 4.5'

Connection made in unknown Street. Work completed

Remarks: Address, contractor & date unknown