

Name **W. Wilbur G. Seely**

Service No. **45 204**

Address **647 Mass. Av. N. Lexington**

1 Upland Rd

Location **1 Upland Road**

Kind of Pipe

Size **6"**

Size of Main **8"**

Investment—New Service

Location

Date	Material	Amount	Total	Date	Amount
11-27-28	32' 3" Clay Pipe @ .30	9 60			
47.22	Sulphur & Jute Trucking	1 28	11 63	Dec. 17, 1928	Cash 47.22
1-1-29	Exc. Labor @ .55	15 95			
2-2-29	" " @ .60	15 00	30 95		
	16% Overhead		4 64		
			47 28		
	Labor				

TOWN OF LEXINGTON—BOARD OF PUBLIC WORKS
SEWER DIVISION

DATE _____

NO. _____


The undersigned applies for the construction of a particular sewer connecting No. 1 Upland Road
Street and hereby agrees to comply with the Rules and Regulations governing the construction and use of Particular
Sewers, as now or at any future time established by the Board of Selectmen.

Am't. of Estimate \$ _____

Am't. Paid \$ _____

Gilbert Sealey Owner

Sketch of Service Here

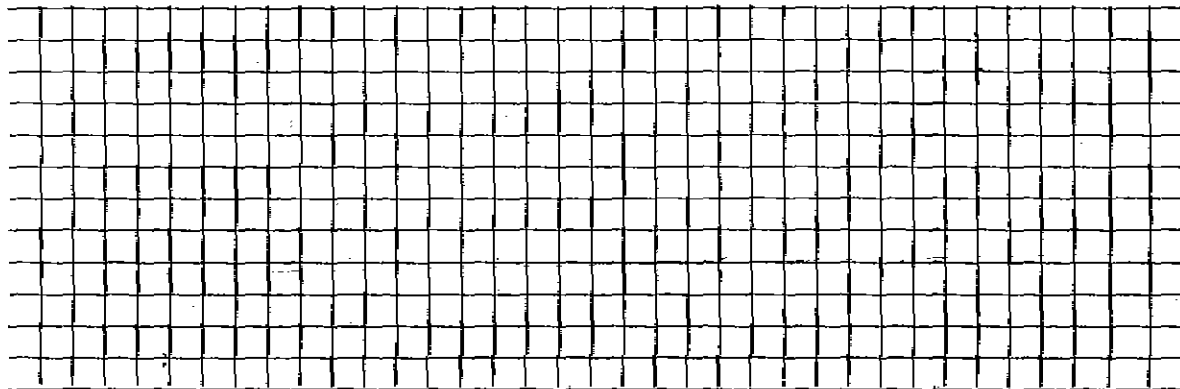

Connection made in _____ Street.

Work completed _____ 19

Remarks: