


DATE _____

TOWN OF LEXINGTON — BOARD OF PUBLIC WORKS

SEWER DIVISION

Sketch of Service Here

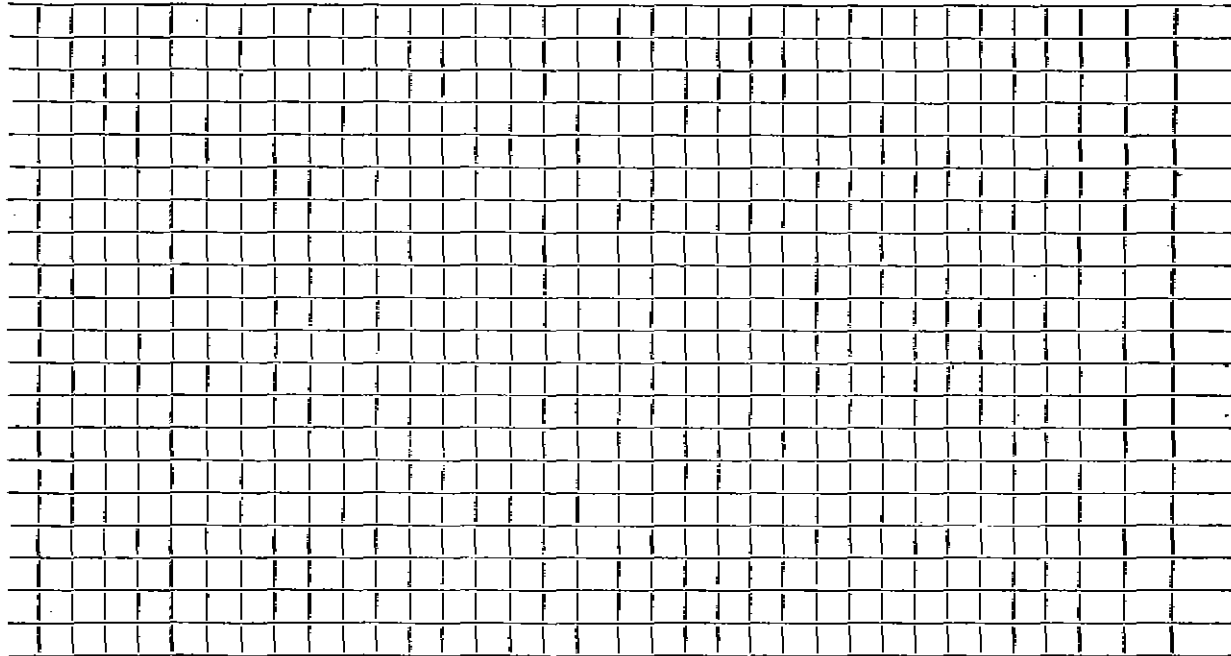

Connection made in Street. Work completed

Remarks: Original Service 12-3-48 (50'-6" Sewer Pipe, 1-6" Elbow)

.....
.....