


DATE 5/2/96

TOWN OF LEXINGTON — BOARD OF PUBLIC WORKS
SEWER DIVISION

Sketch of Service Here **6**

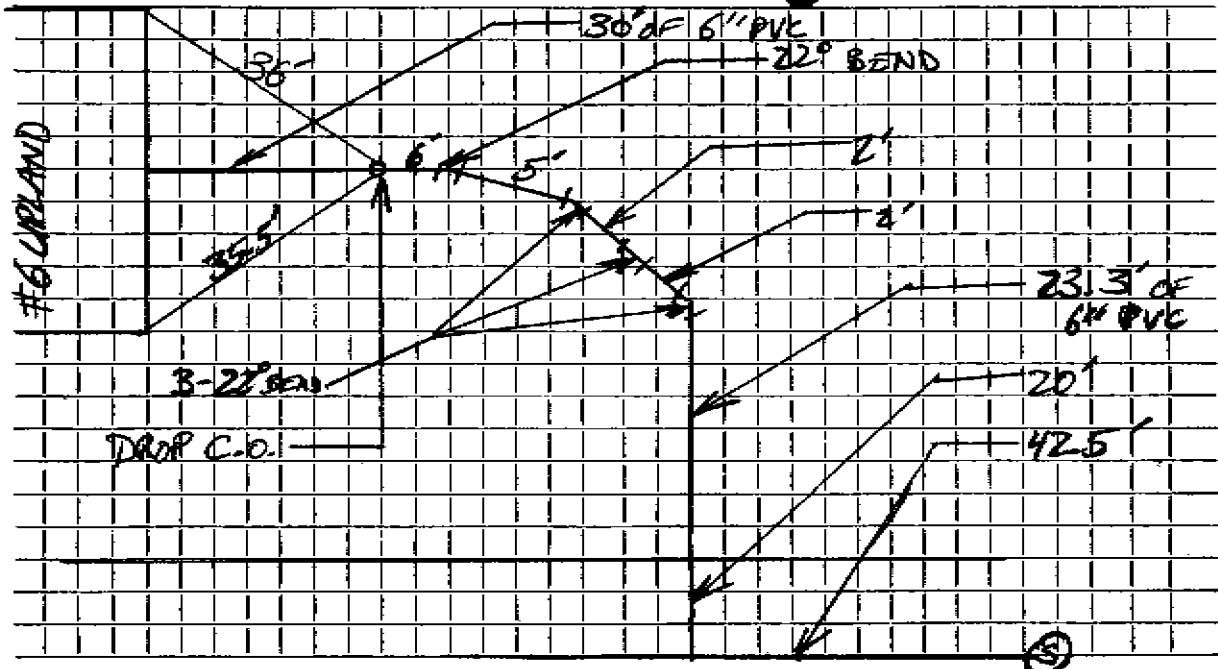

Connection made in Street. Work completed

Remarks: Original Service